


T.6S. & 7S.R.1E.W.M.

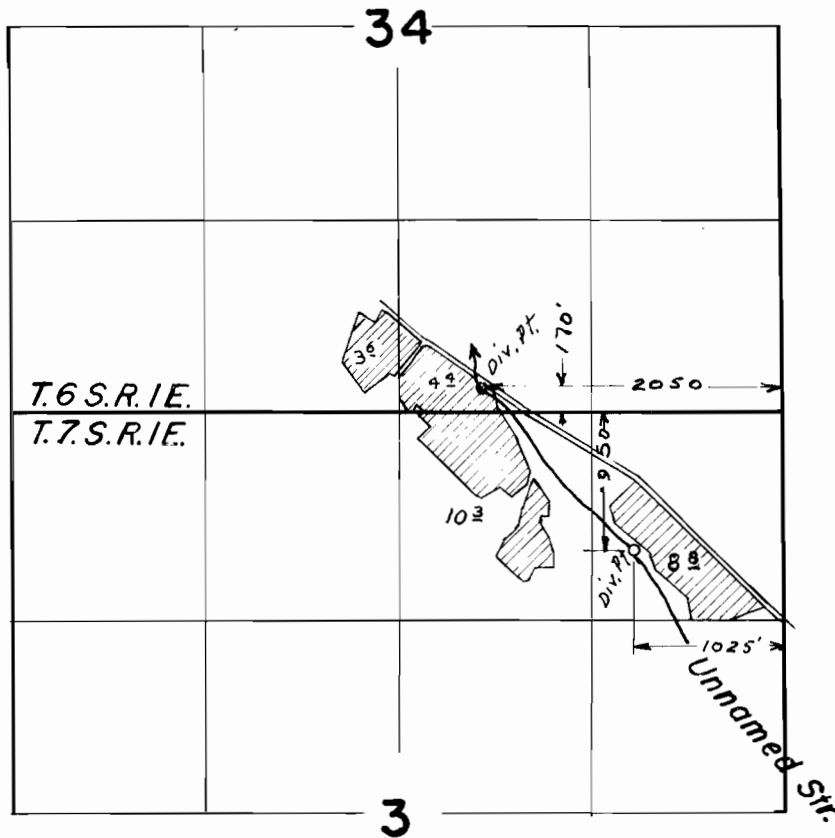

FINAL PROOF SURVEY
UNDER

Application No. 31471 Permit No. 24812
IN NAME OF

Vernon F. & Fredora I. Rock

Surveyed June 30 1965, by F. Siegmund