


T. 6 S. R. 2 W. W. M.

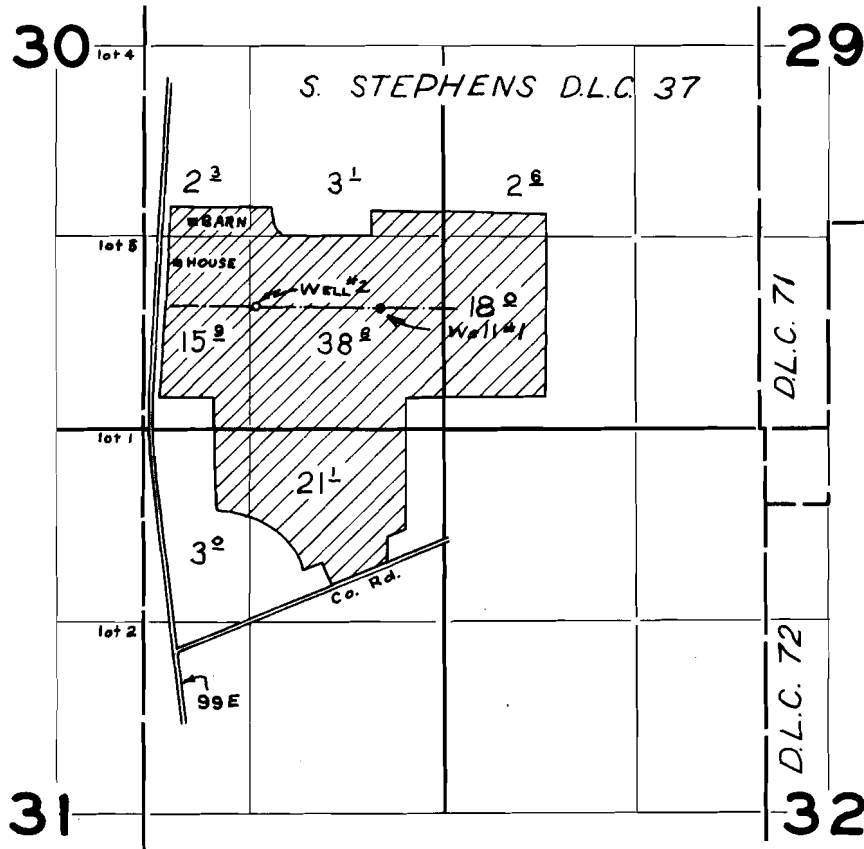

RR Spike
in Road → S.W. Cor
D.L.C. 37

FINAL PROOF SURVEY UNDER

Application No. G-2008 Permit No. G-1853
IN NAME OF

D.E. AND W.B. TURNIDGE

Surveyed JUN. 24 1964, by R. JACKSON