


T. 8 S. R. 6 W. W. M.

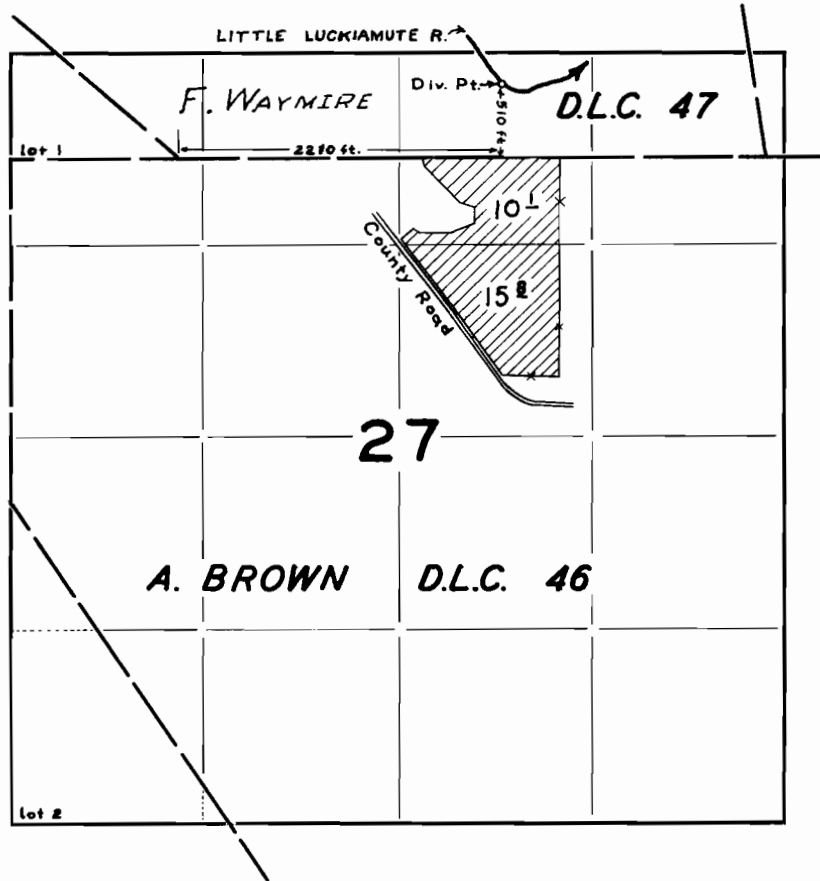

FINAL PROOF SURVEY  
UNDER

Application No. 37328 Permit No. 27805  
IN NAME OF

**STURE OLSSON**

Surveyed JUL 17, 1964 by R. JACKSON