


T. 8 S. R. 6 W. W. M.

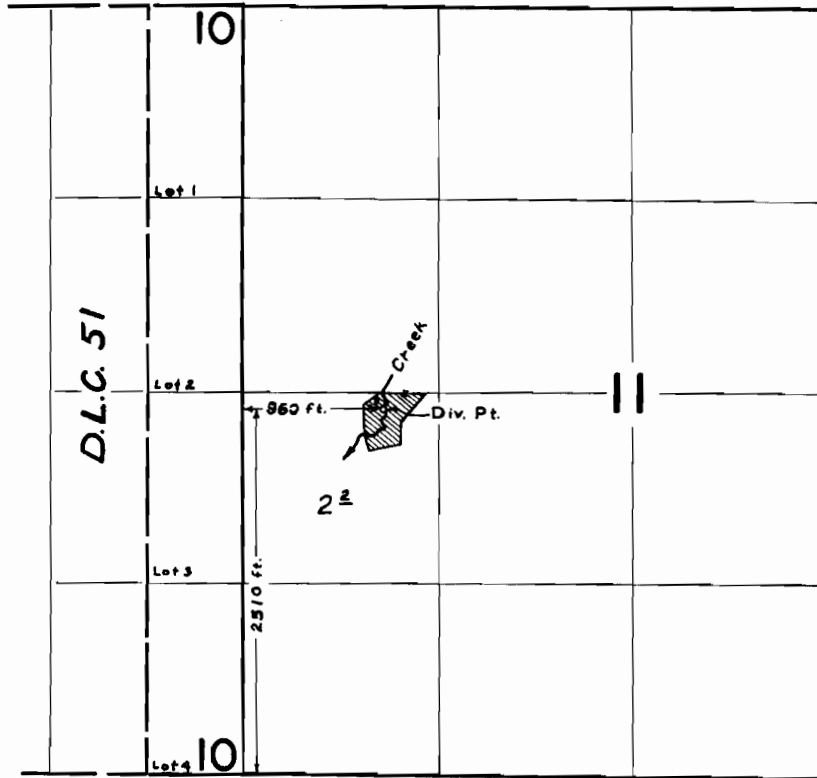

FINAL PROOF SURVEY
UNDER

Application No. 34668 Permit No. 27228
IN NAME OF

L. R. SPIRES

Surveyed JUL 17 1964 by R. JACKSON