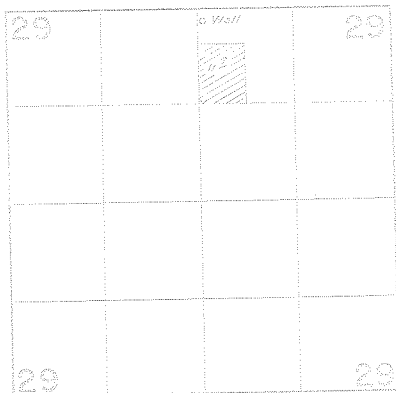


T. 6N. R. 35E. W.M.

FINAL PROOF SURVEY
UNDERApplication No. G-1830, Parcel No. G-1669,
IN NAME OF

C. E. & ELVA EYLER

Surveyed April 19, 1964, by B. Jackson