


T. 6 N. R. 35 E. W. M.

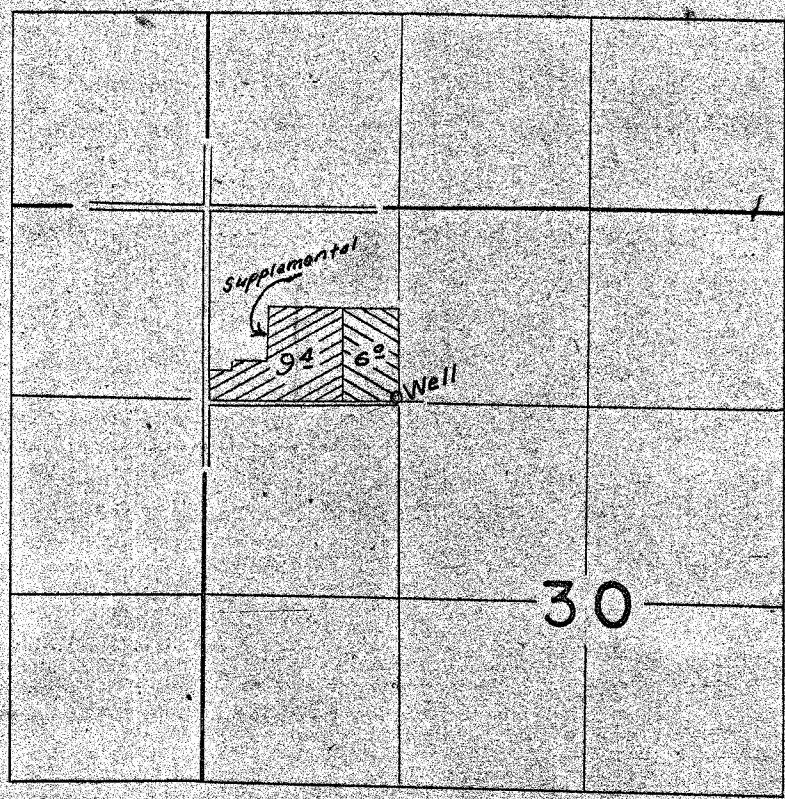

FINAL PROOF SURVEY UNDER

Application No. G-2485, Permit No. G-2295
IN NAME OF

ESTATE of A. L. HAND

Surveyed April 18, 1964, by R. Jackson