


T.6N. R.35E. W.M.

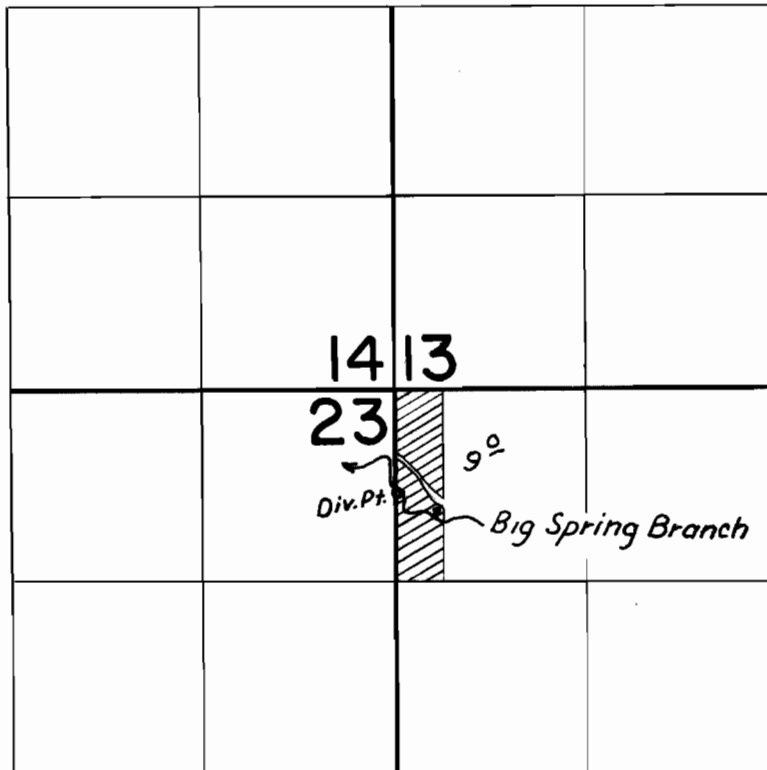

**FINAL PROOF SURVEY**  
UNDER

Application No. 38063. Permit No. 28384.  
IN NAME OF

*GILBERT LARUE and WIFE*

Surveyed April 20, 1964, by R. Jackson