


T.6N. R.35E. W.M.

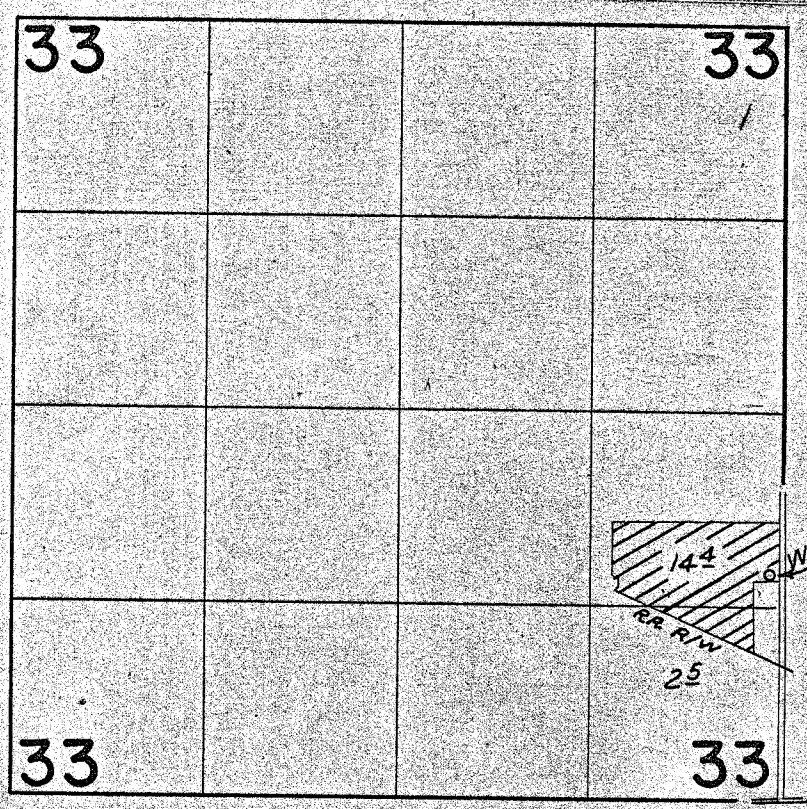

FINAL PROOF SURVEY UNDER

Application No. G-2431... Permit No. G-2282...
IN NAME OF

CHARLES J. NAGELE

Surveyed April 20, 1964, by R. Jackson.....