


Basin 7
6-1729
33486

T.3N.R.29E.W.M.

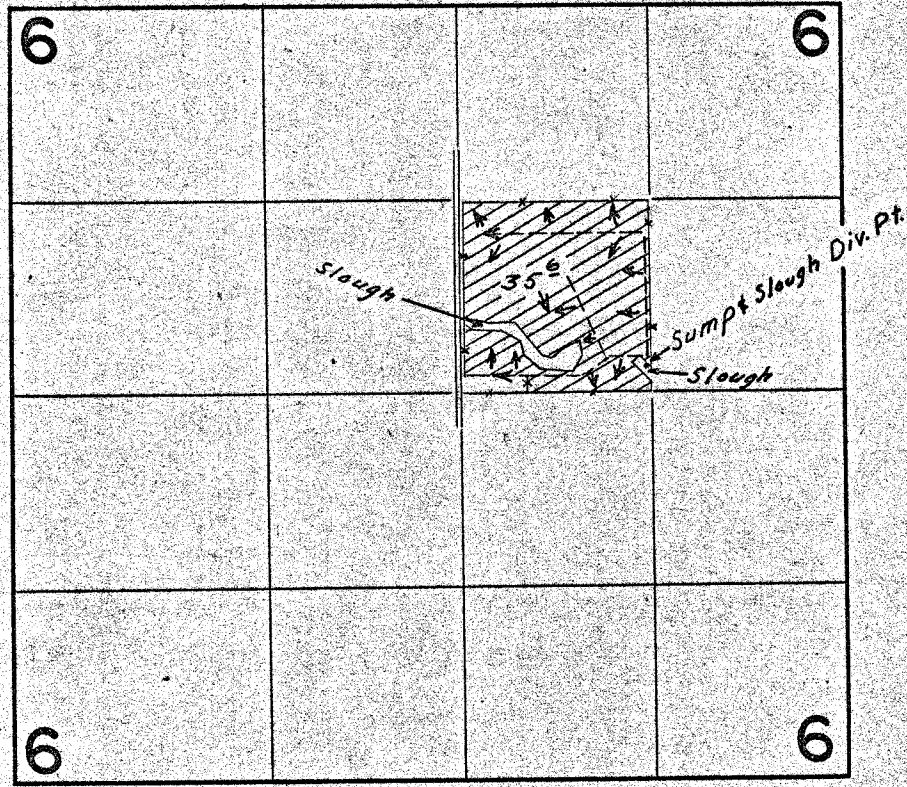

FINAL PROOF SURVEY UNDER

34207 26863
Application No. 6-1890... Permit No. 6-1729...
IN NAME OF

ROBERT. W. RHAE

Surveyed April 15, 1964, by R. Jackson.....

*Application
map next page* 1964-A
CJG