


T.3N.R.29E.W.M.

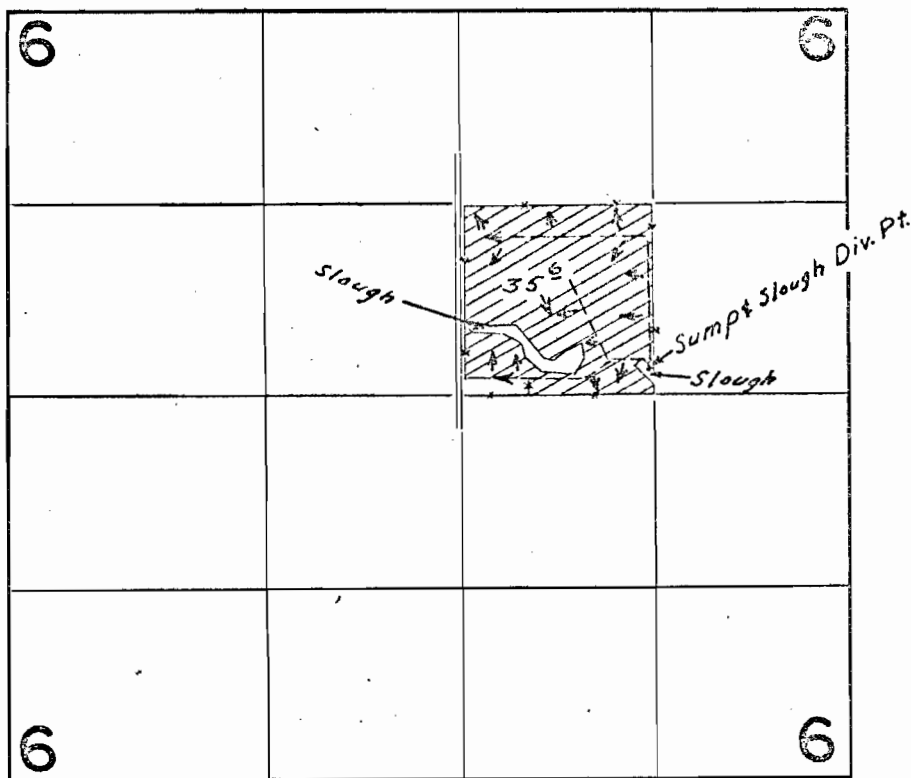


FINAL PROOF SURVEY
UNDER

34207 26863
Application No. G-1890 Permit No. G-1729
IN NAME OF

ROBERT. W. RHAE

Surveyed April 15, 1964, by R. Jackson.....

T.3N.R.29E.W.M.

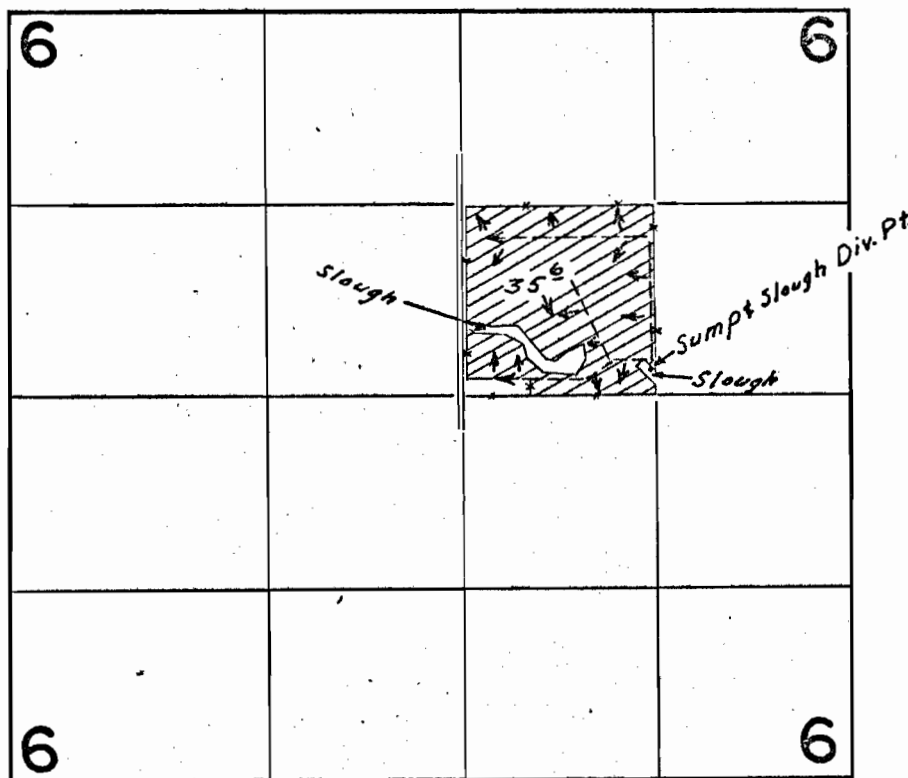

FINAL PROOF SURVEY
UNDER

34207 26863
Application No. G-1890 Permit No. G-1729
IN NAME OF

ROBERT. W. RHAЕ

Surveyed April 15, 1964, by R. Jackson