


# T.6N.R.36E.W.M.

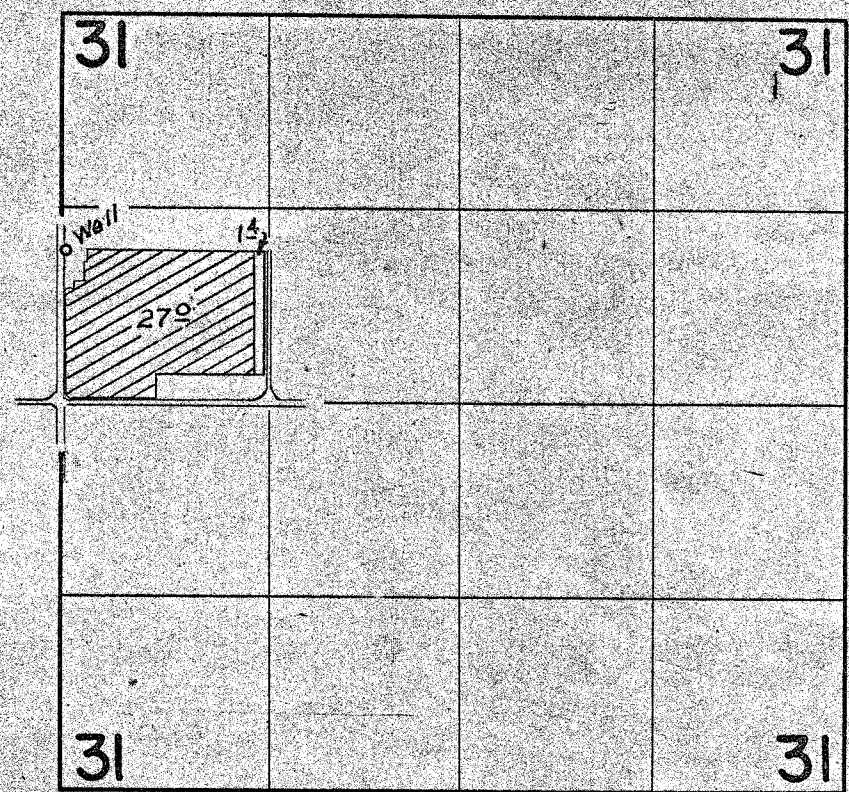

## FINAL PROOF SURVEY UNDER

Application No. G-2379 Permit No. G-2201  
IN NAME OF  
**LAWRENCE W. TIMMONS**

Surveyed April 17, 1964, by R. Jackson