


T.6N. R.36E. W.M.

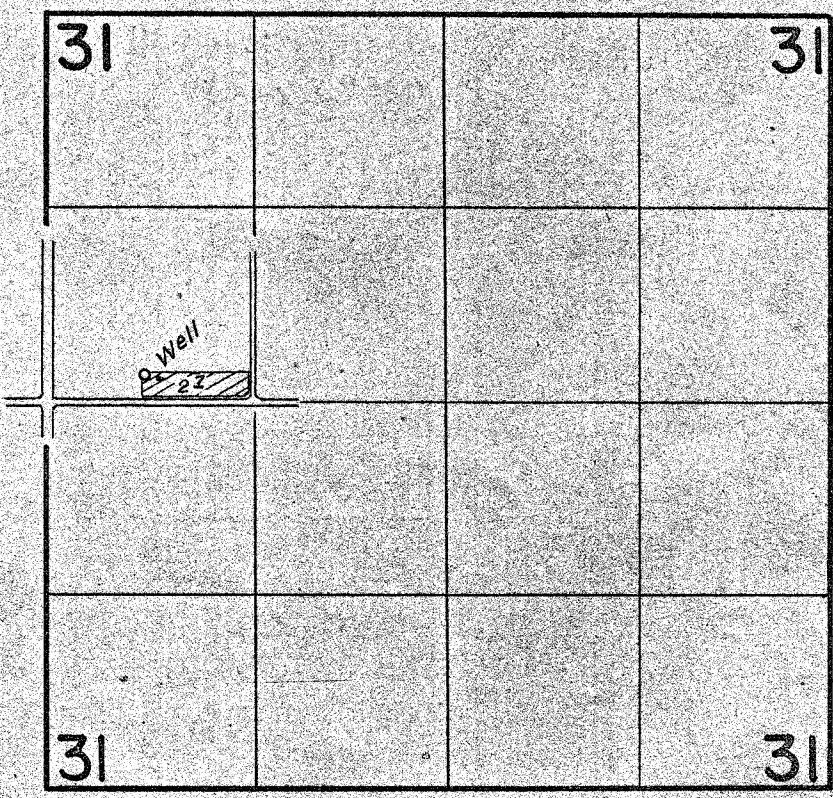

FINAL PROOF SURVEY UNDER

Application No. G-2284 Permit No. G-2110
IN NAME OF

MARVIN TIMMONS

Surveyed April 17, 1964, by R. Jackson