


T.4 & 5 S. R. 5 W. M.

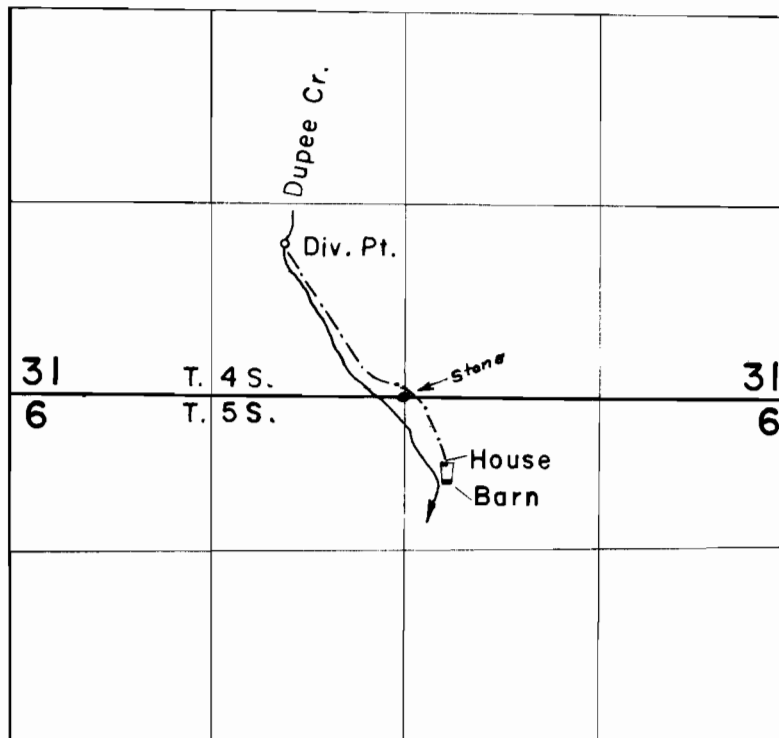

FINAL PROOF SURVEY
UNDER

Application No. 38821 Permit No. 28889
IN NAME OF

VERN E. DICKEY

Surveyed Aug. 28 1964, by R. Jackson