


T.3S.R.5W.W.M.

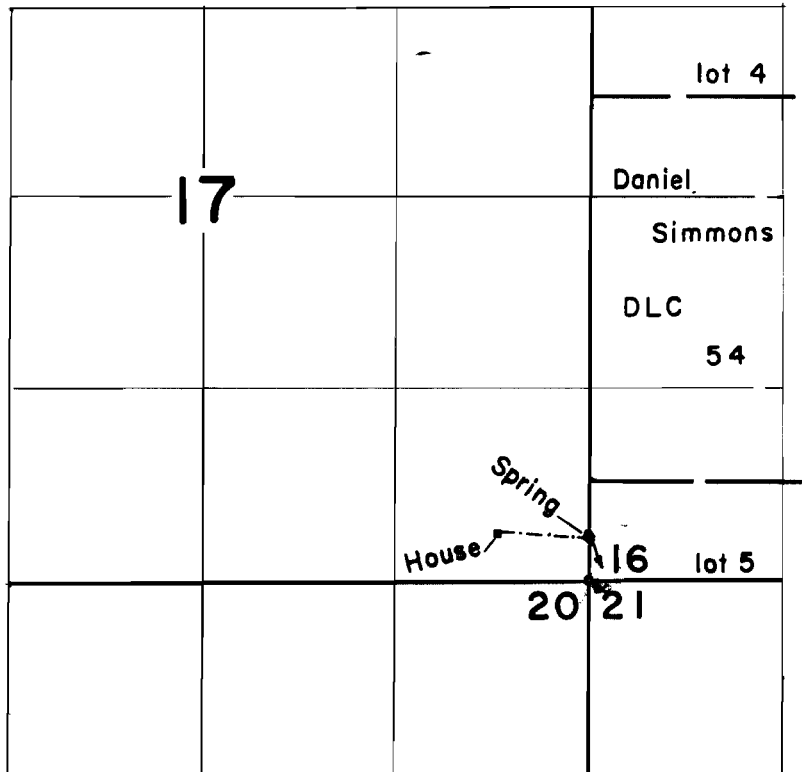

FINAL PROOF SURVEY
UNDER

Application No. 38800... Permit No. 28885...
IN NAME OF

..... Harry M. Drew

Surveyed Aug. 28 1964, by R. Jackson.....