


T.5S.R.7W.W.M.

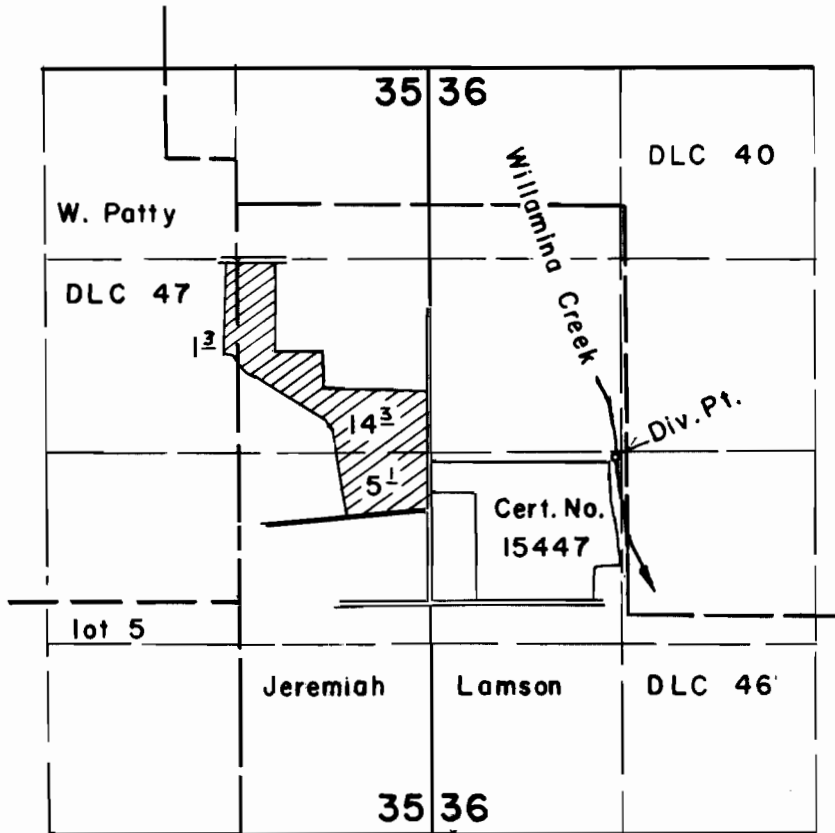

FINAL PROOF SURVEY
UNDER

Application No. 32797 Permit No. 25874
IN NAME OF

Gordon & Jim Fowler

Surveyed Sept. 24 1964, by R. Jackson