


T.4S.R.4W.W.M.

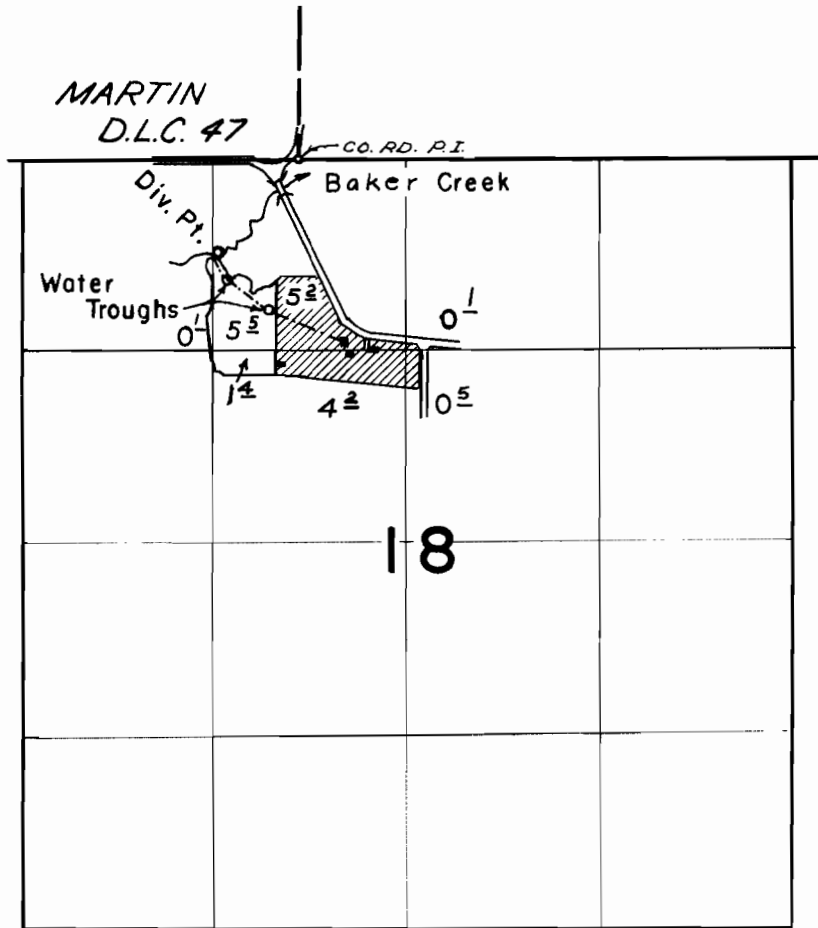

**FINAL PROOF SURVEY**  
UNDER

Application No. 34892... Permit No. 27400...  
IN NAME OF

..... L. A. Grenfell .....

Surveyed Aug. 25, 1964, by R. Jackson.....