


T.3S.R.3W.W.M.

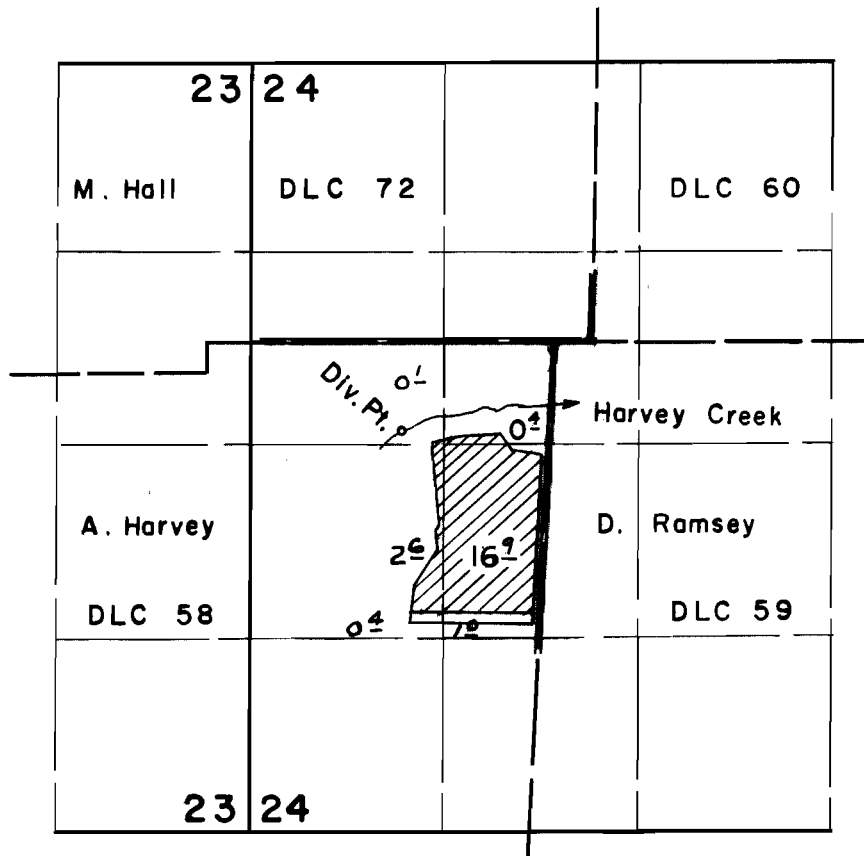

FINAL PROOF SURVEY UNDER

Application No. 37078... Permit No. 27652...
IN NAME OF

J. Millard Leslie

Surveyed Sept. 23 1964, by R. Jackson