


T.6S. R.2E. W.M.

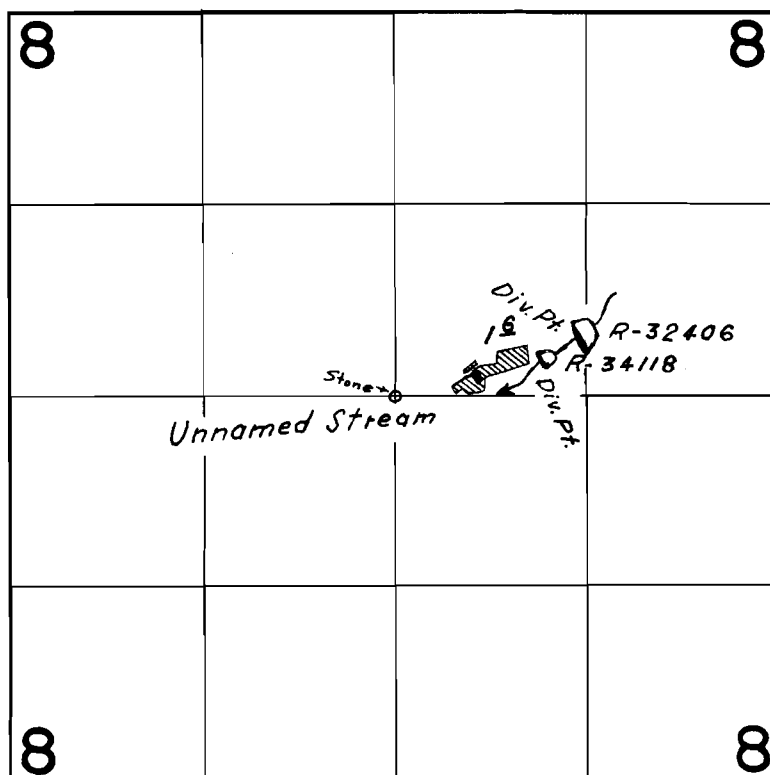

FINAL PROOF SURVEY

UNDER

R-32406

R-2148

32407

25534

R-34118

R-2458

Application No. 34117 Permit No. 26890

IN NAME OF

OTTO L. & CLAUDIA B. HUDRLIK

Surveyed July 21, 1964, by C.J. Gardner
April 6, 1962 T.L. Lauer