


T.4S. R.3E. W.M.

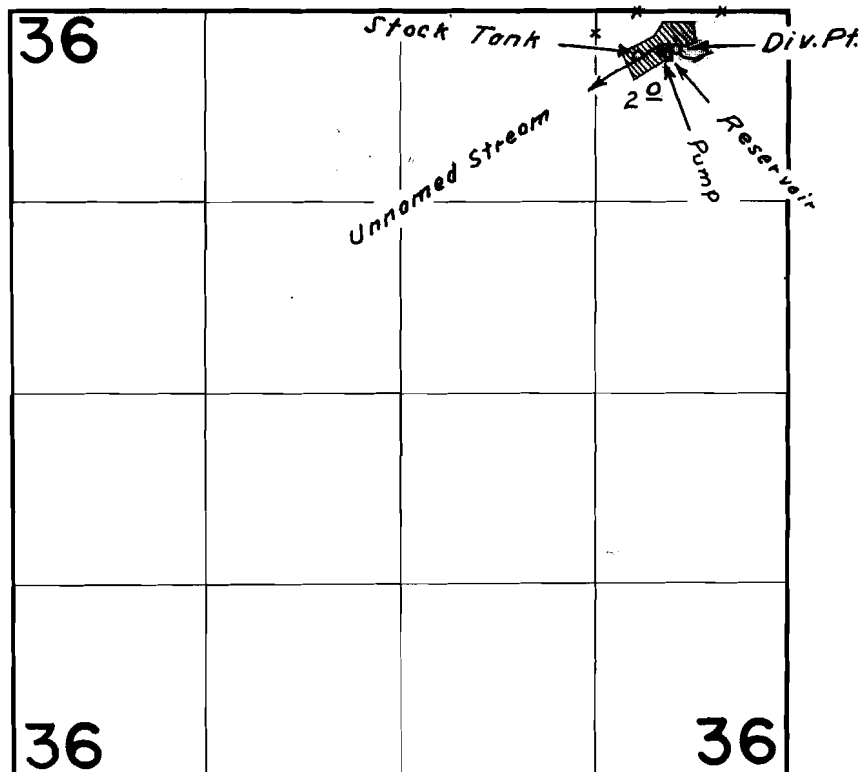

FINAL PROOF SURVEY
UNDER

32578 25716
Application No. R-32577 Permit No. R-2173
IN NAME OF

JOE STOCKER

Surveyed July 21, 1964, by C.J. Gardner