


T.26S. R.5W. W.M.

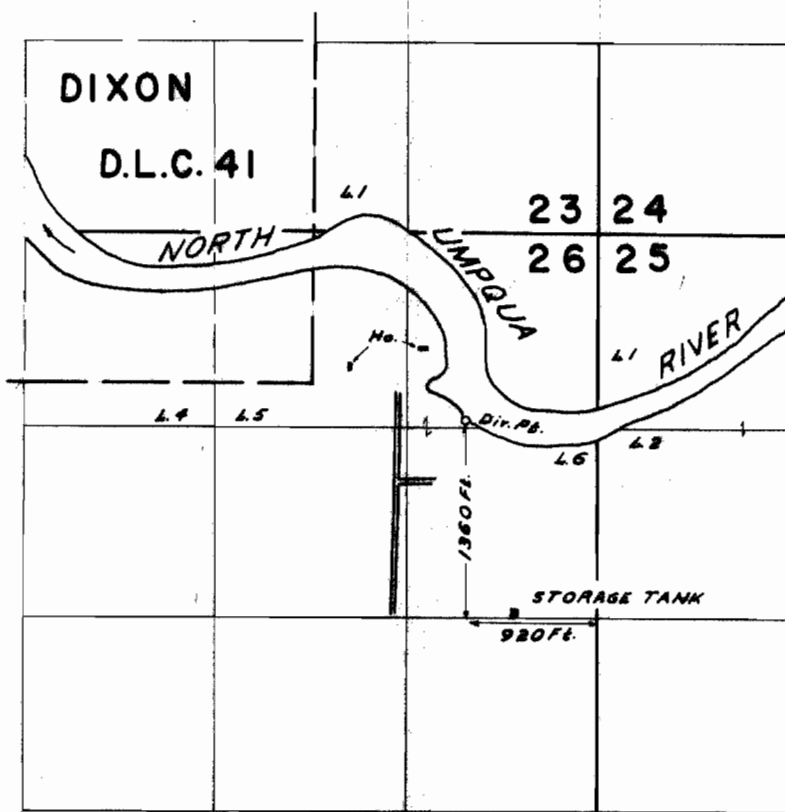

**FINAL PROOF SURVEY**  
UNDER

Application No. 39751... Permit No. 29563  
IN NAME OF

FRANK L. STRADER

Surveyed AUG. 11, 1965, by L. COLEBANK