


T. 35 S. R. 32 E W.M.

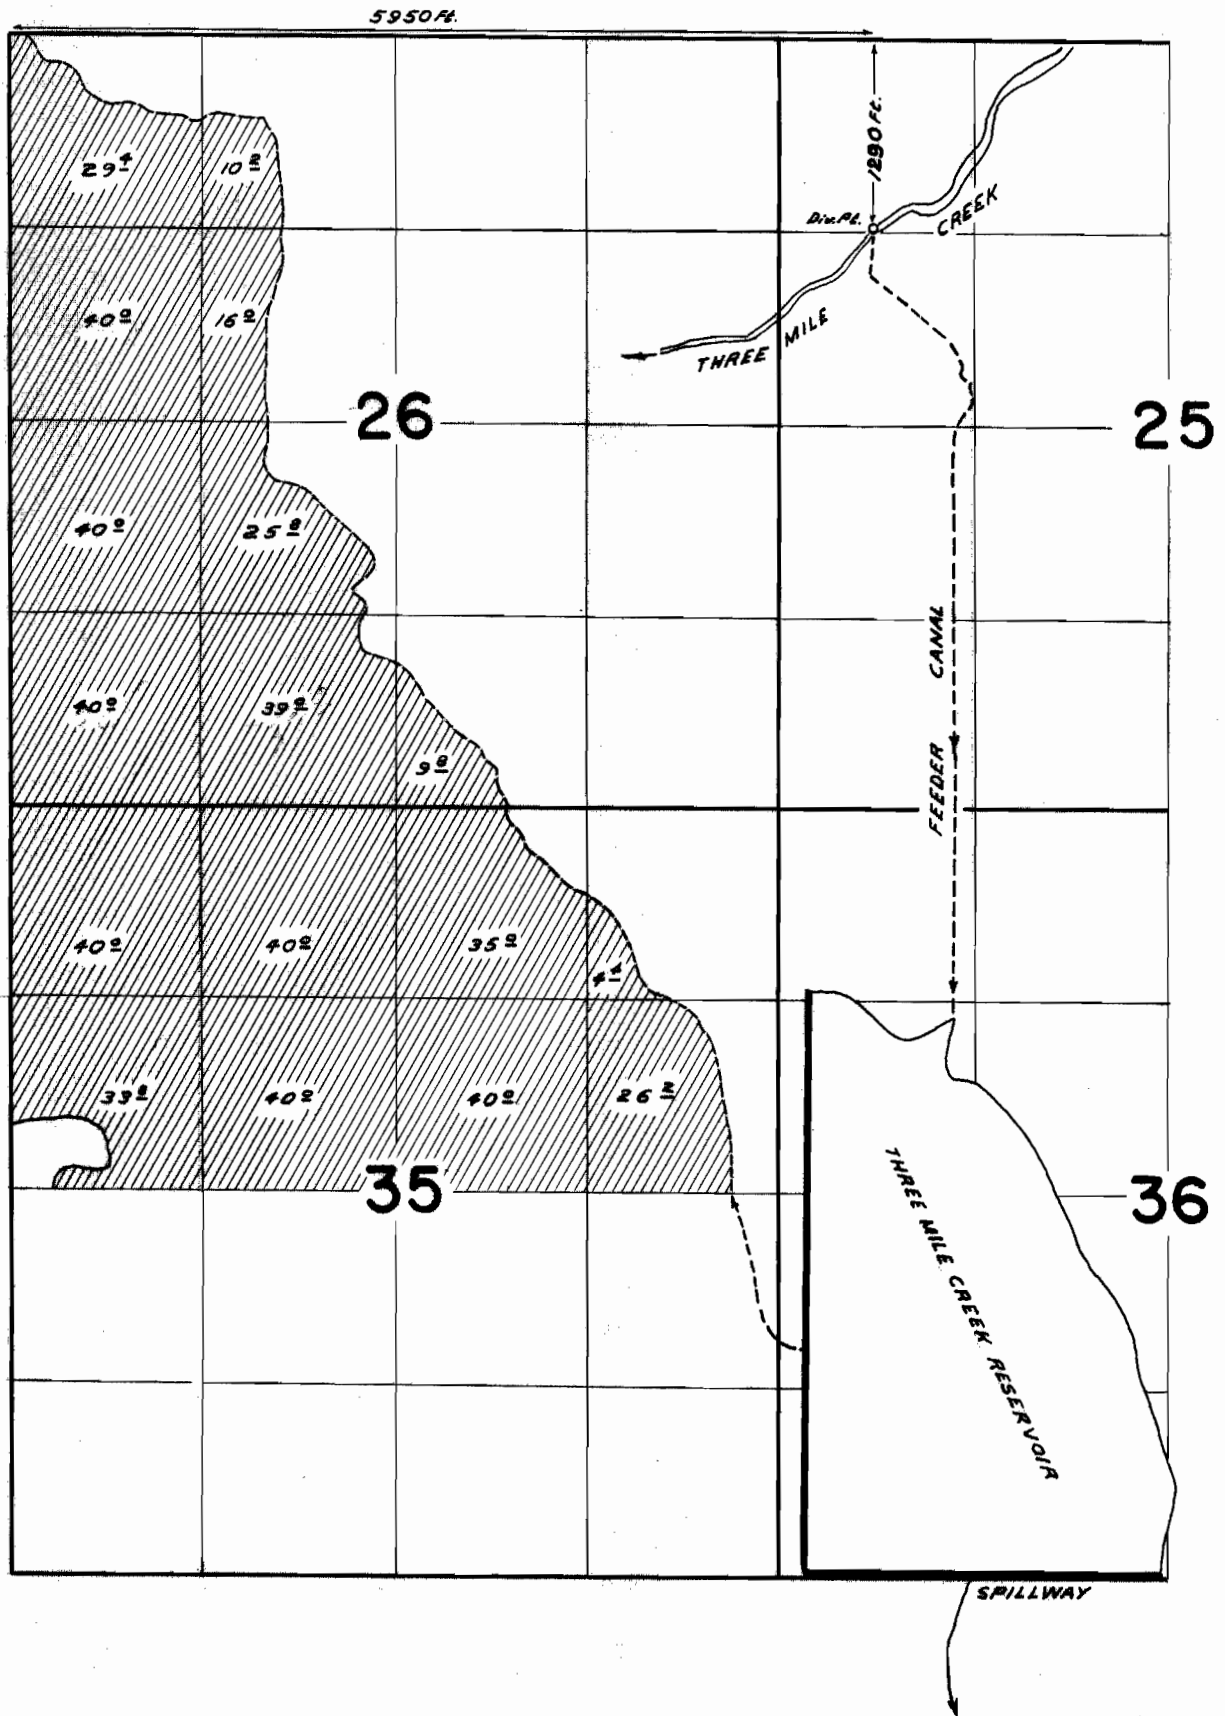

FINAL PROOF SURVEY

UNDER

APPLICATION No. R-21001 PERMIT No. R-838
21002 16911

IN NAME OF
ALLIED LAND & LIVESTOCK CO.

SURVEYED AUG. 24, 1963 BY T. LAUER
SEPT. 21, 1965 BY L. COLEBANK