


T.32S.R.32E.W.M.

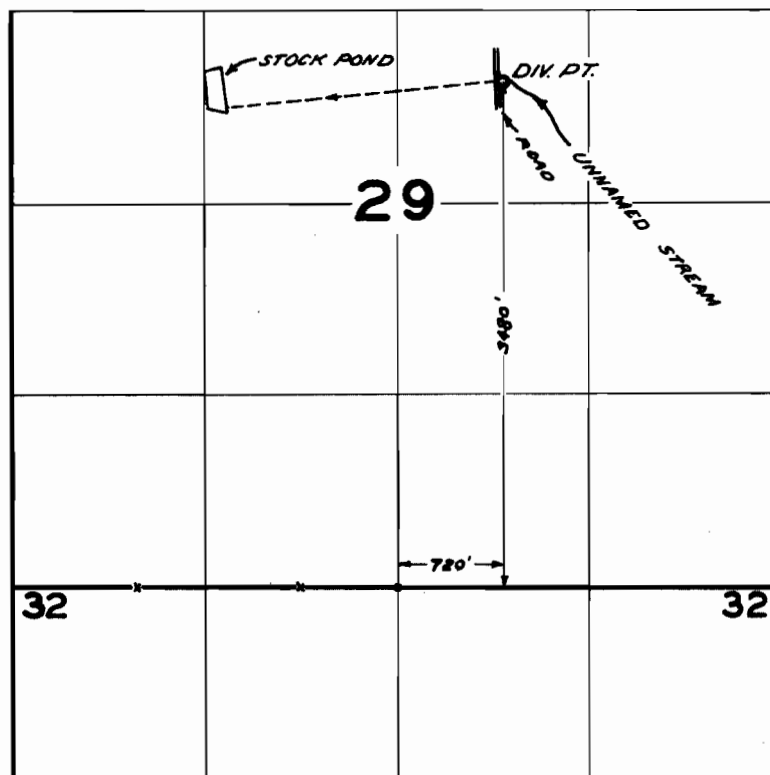

FINAL PROOF SURVEY
UNDER

Application No. 22102 Permit No. 17418
IN NAME OF

ALLIED LAND & LIVESTOCK CO.

Surveyed AUG 21 1963, by T. LAUER