


T. 37S. R. 1 & 2 E. W. M.

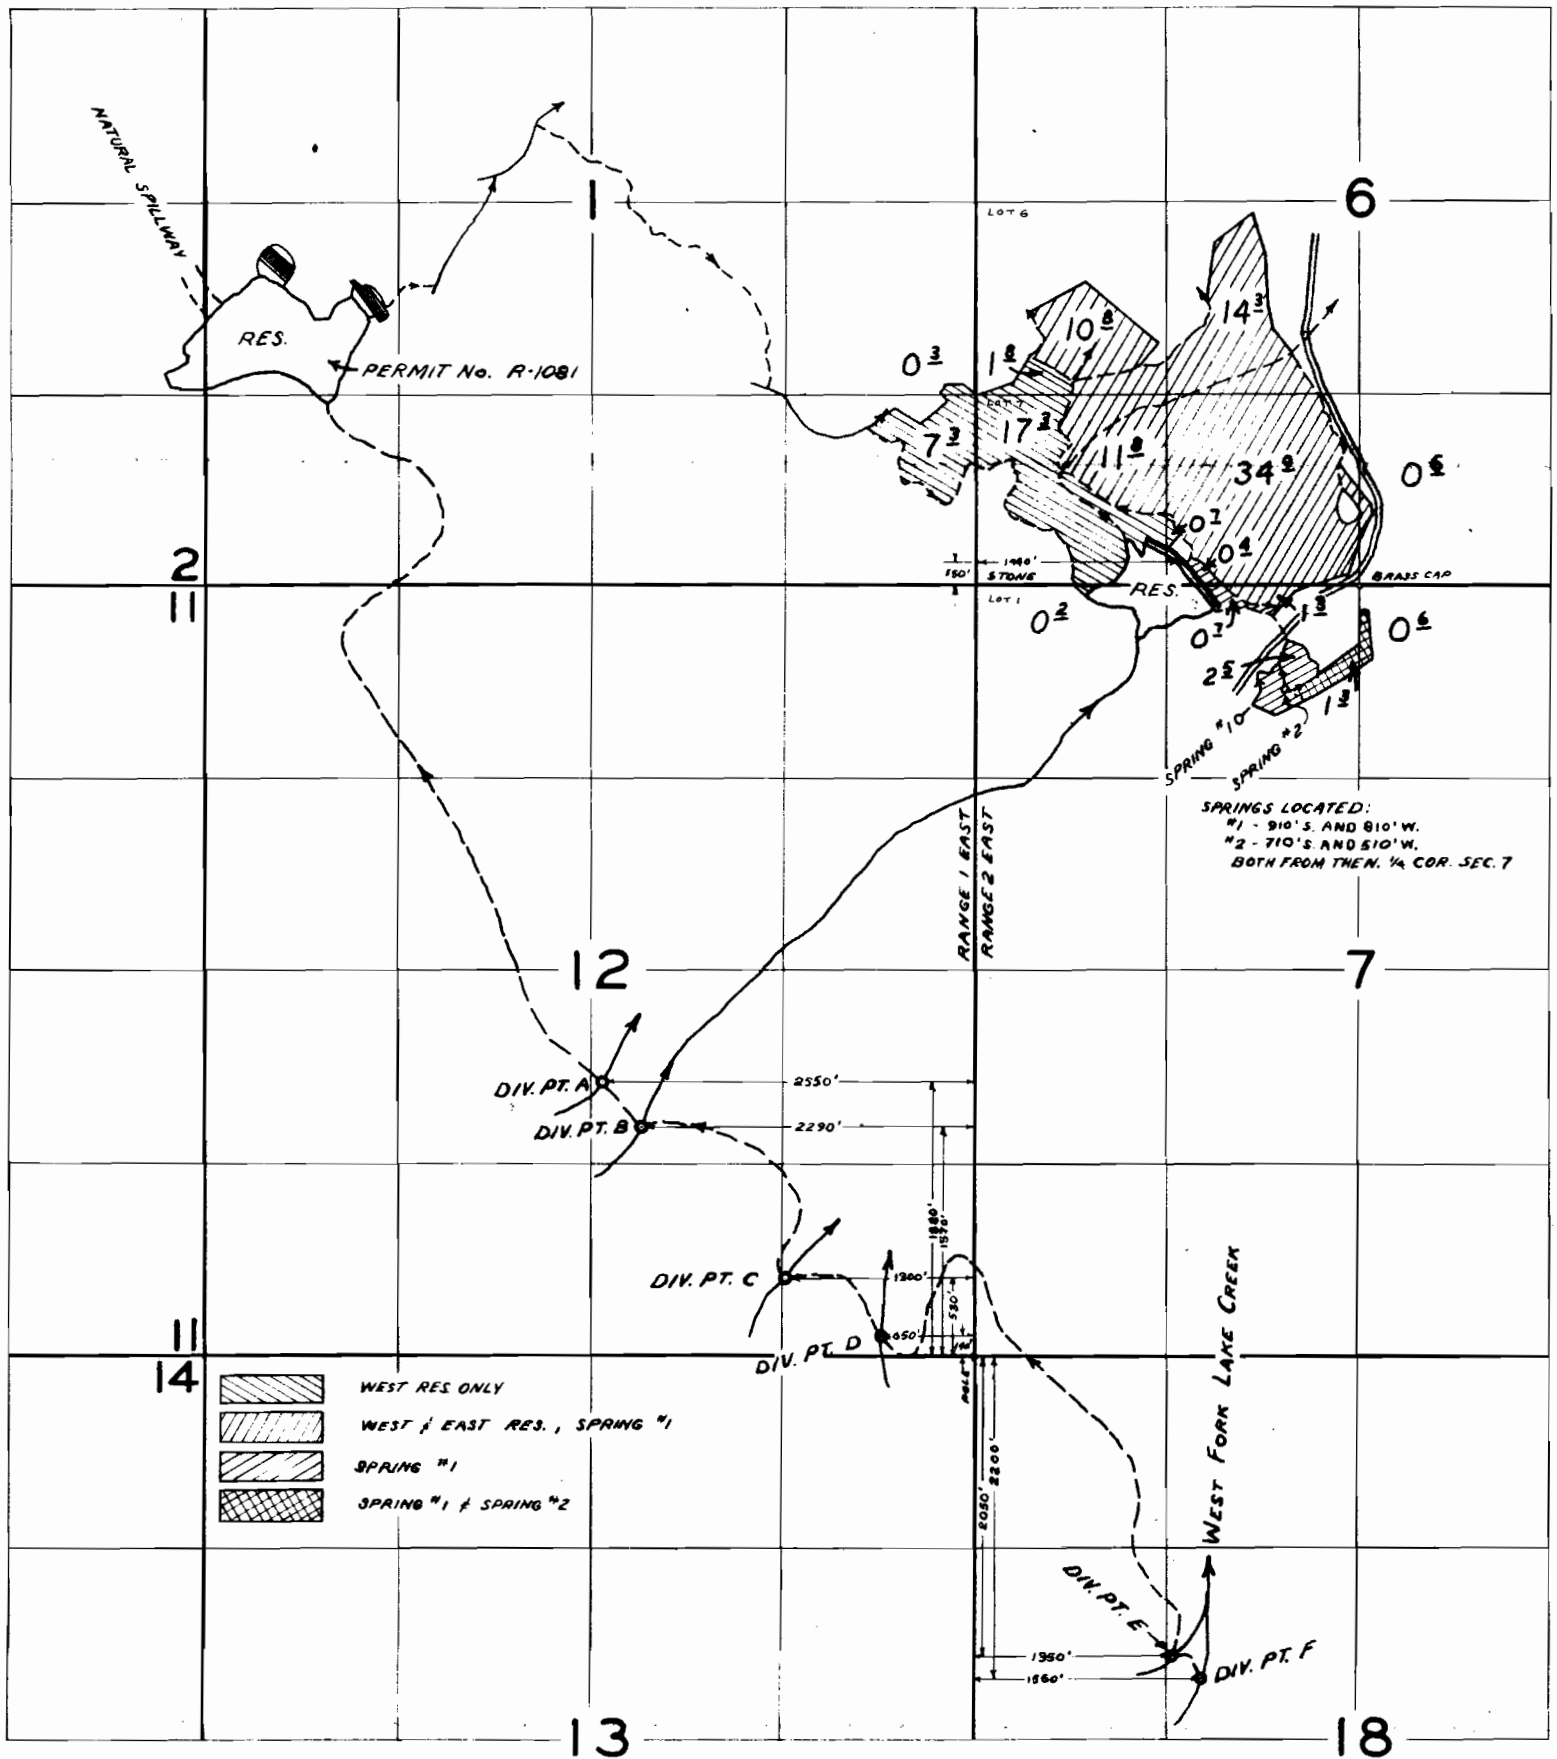

FINAL PROOF SURVEY

UNDER

R-41031
41032
R-25358

R-4614
30634
R-1081

APPLICATION NO. 25359 PERMIT NO. 19882

IN NAME OF

LEONARD BRADSHAW &
MERTON BRADSHAW

SURVEYED APR. 7-8-9, 1960 BY M. BISH
JUL. 16-17-21-22, 1965 BY C. GARDNER
INSPECTED FEB. 17, 1966 BY D. HENDRIX