


T.37S.R.1&2E.W.M.

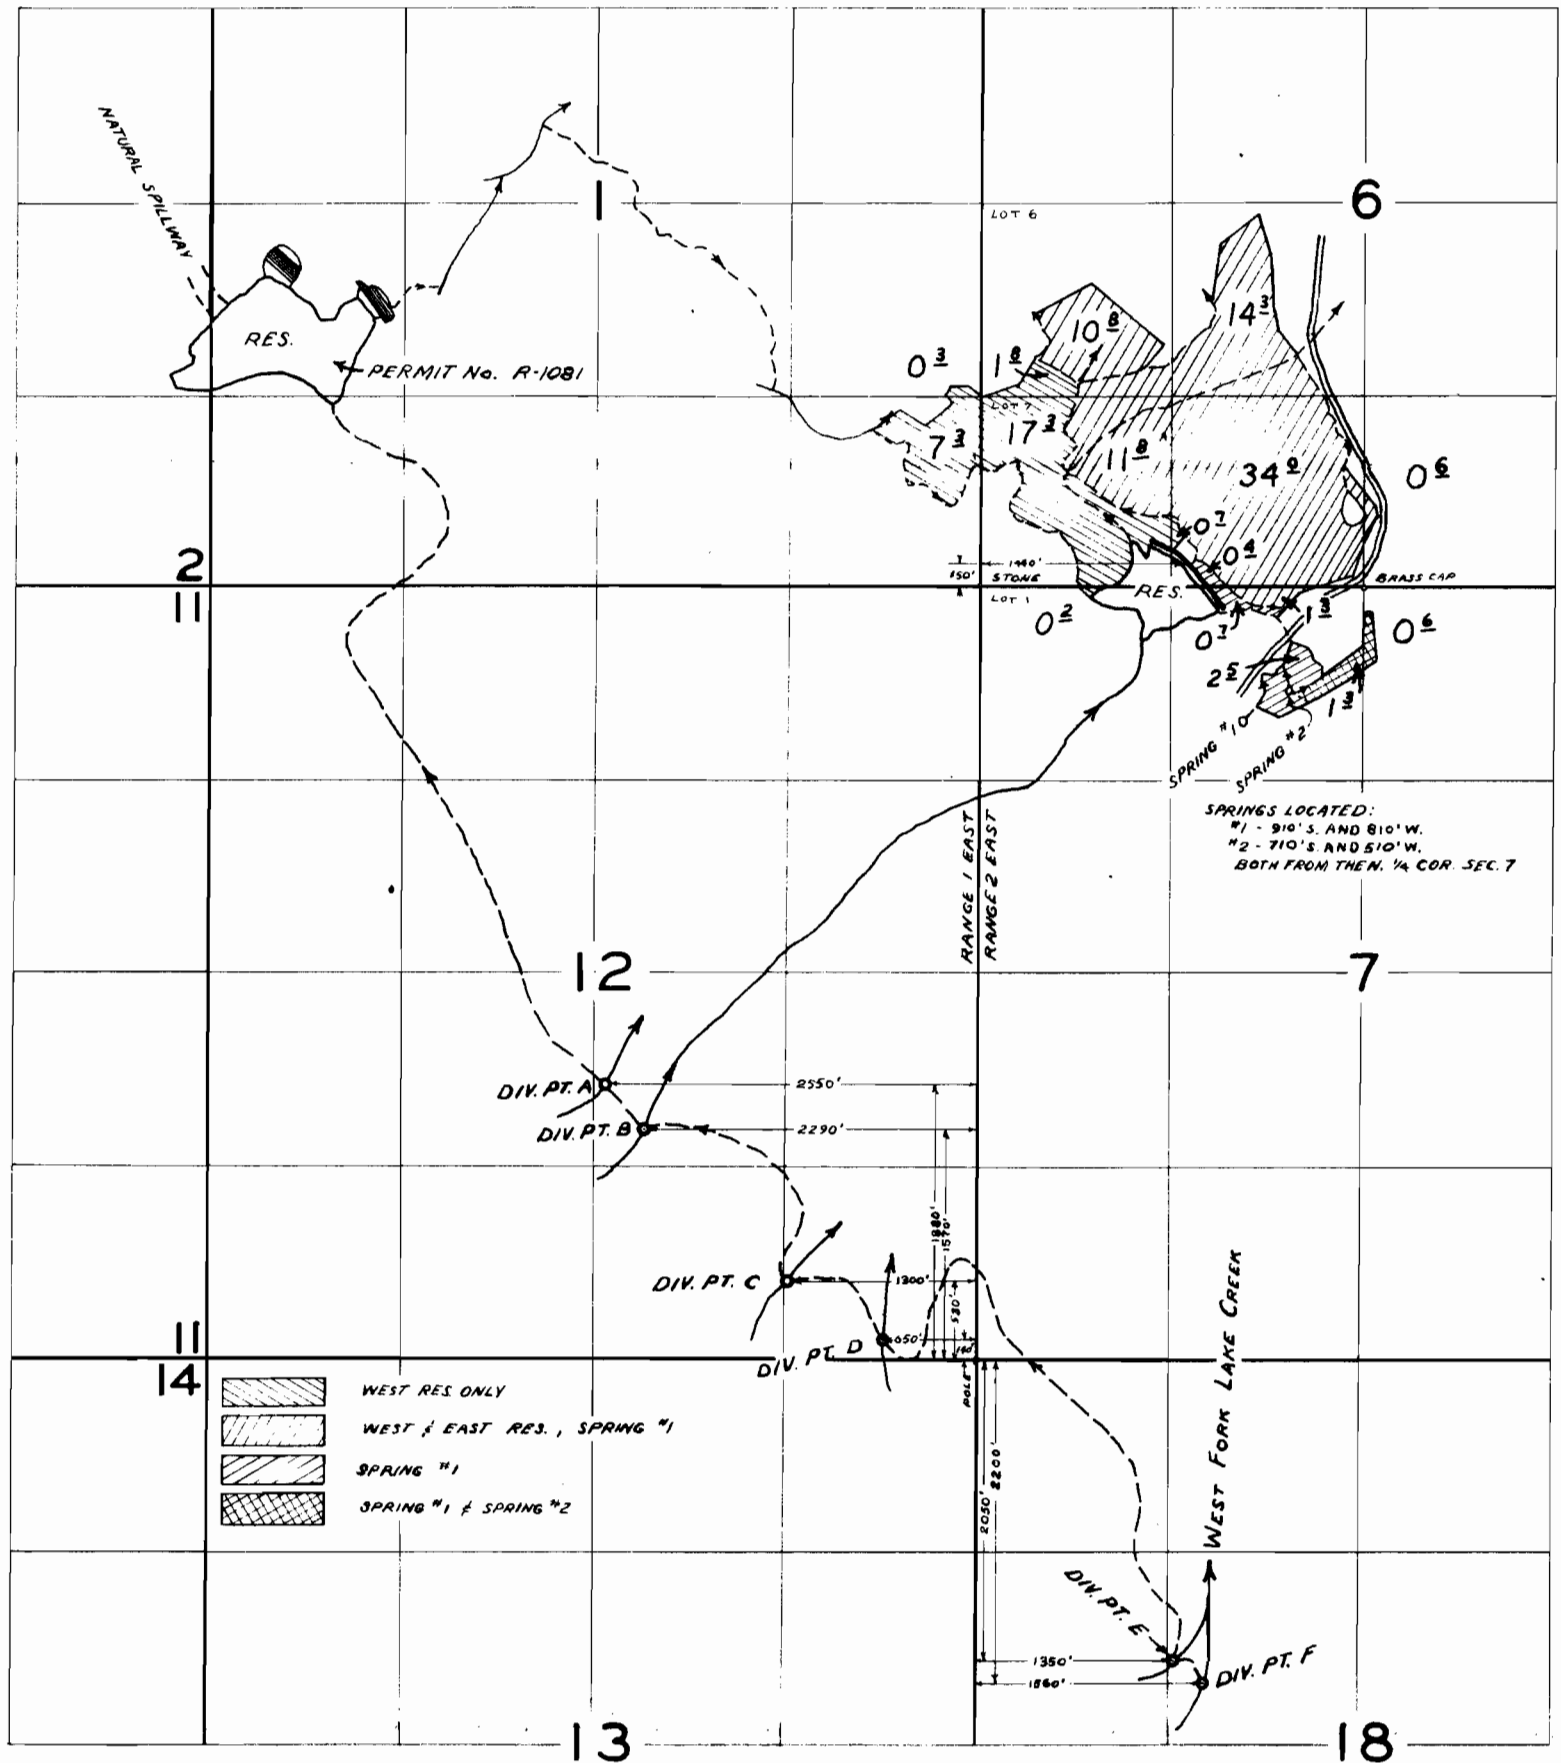

FINAL PROOF SURVEY

UNDER

R-41031
41032
R-25358
25359

R-4614
30634
R-1081
19882

APPLICATION NO. PERMIT NO.

IN NAME OF
**LEONARD BRADSHAW &
MERTON BRADSHAW**

SURVEYED APR. 7-8-9, 1960 BY M. BISH
JUL. 16-17-21-22, 1965 BY C. GARDNER
INSPECTED FEB. 17, 1966 BY D. HENDRIX