


R-2328
33519

T.4S.R.8E.W.M.

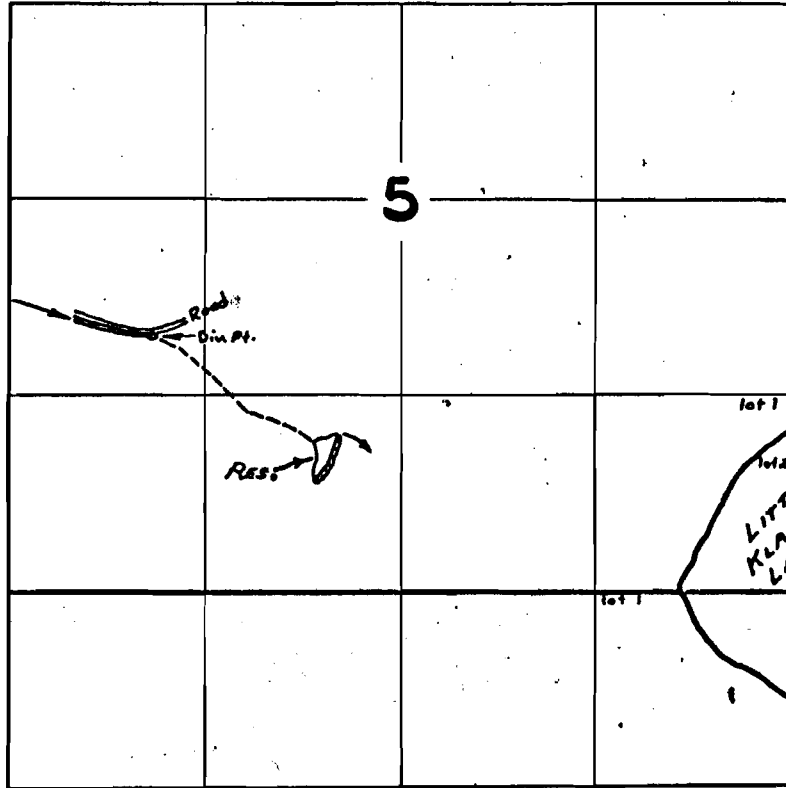

Klamath R. Mide.

FINAL PROOF SURVEY UNDER

Application No. ~~33626~~ ³³⁶²⁶ ~~R-33627~~ ^{R-33627} Permit No. ~~26586~~ ²⁶⁵⁸⁶ ~~R-2328~~ ^{R-2328} ✓
 IN NAME OF

CHARLES E. OWEN

Surveyed Jun. 23 1964, by R. JACKSON