


T.41S.R.8E.W.M.

Klamath River Misc.

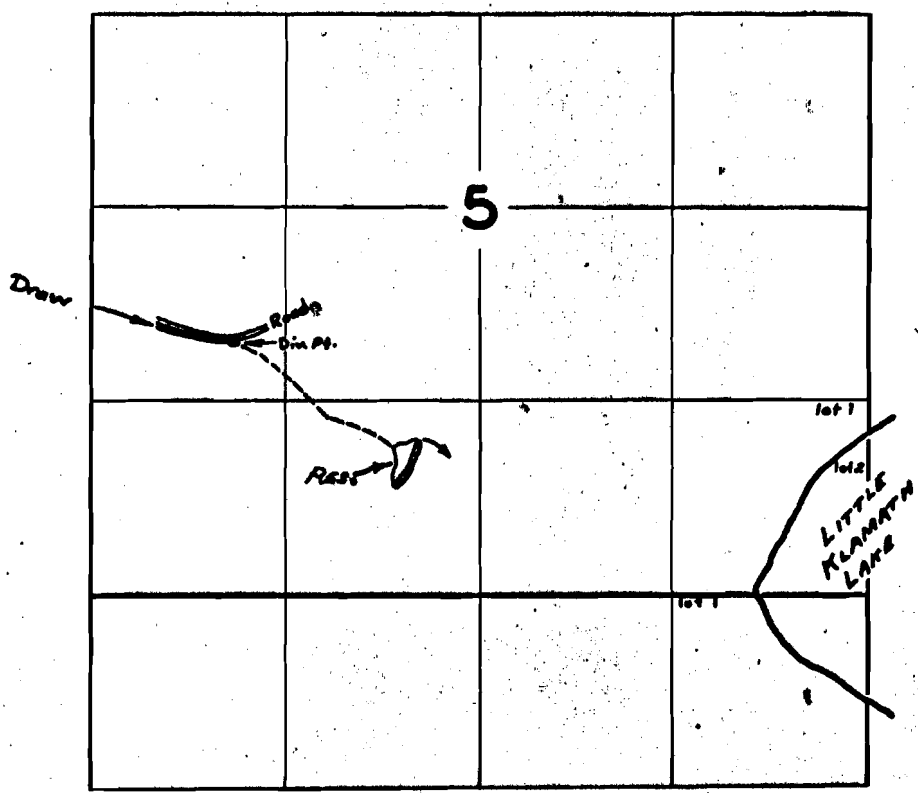

FINAL PROOF SURVEY UNDER

Application No. ~~33626~~ ³³⁶²⁶ R-31627 Permit No. ~~26586~~ ²⁶⁵⁸⁶ R-2228
IN NAME OF

CHARLES E. OWEN

Surveyed Jan 23 1964, by R. Jackson