


T. 4 S. R. 1 W. W. M.

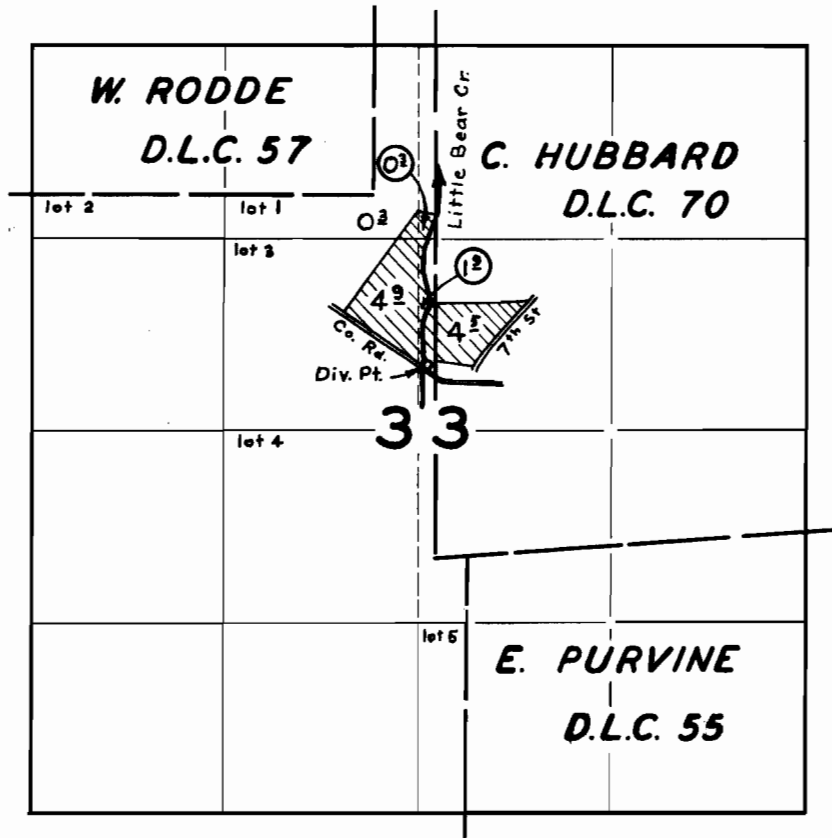

FINAL PROOF SURVEY
UNDER

Application No. 38106 Permit No. 28405
IN NAME OF

LELAND T. DUNN

Surveyed APR. 6 1964, by R. JACKSON