


T. 16 S. R. 4 W. W. M

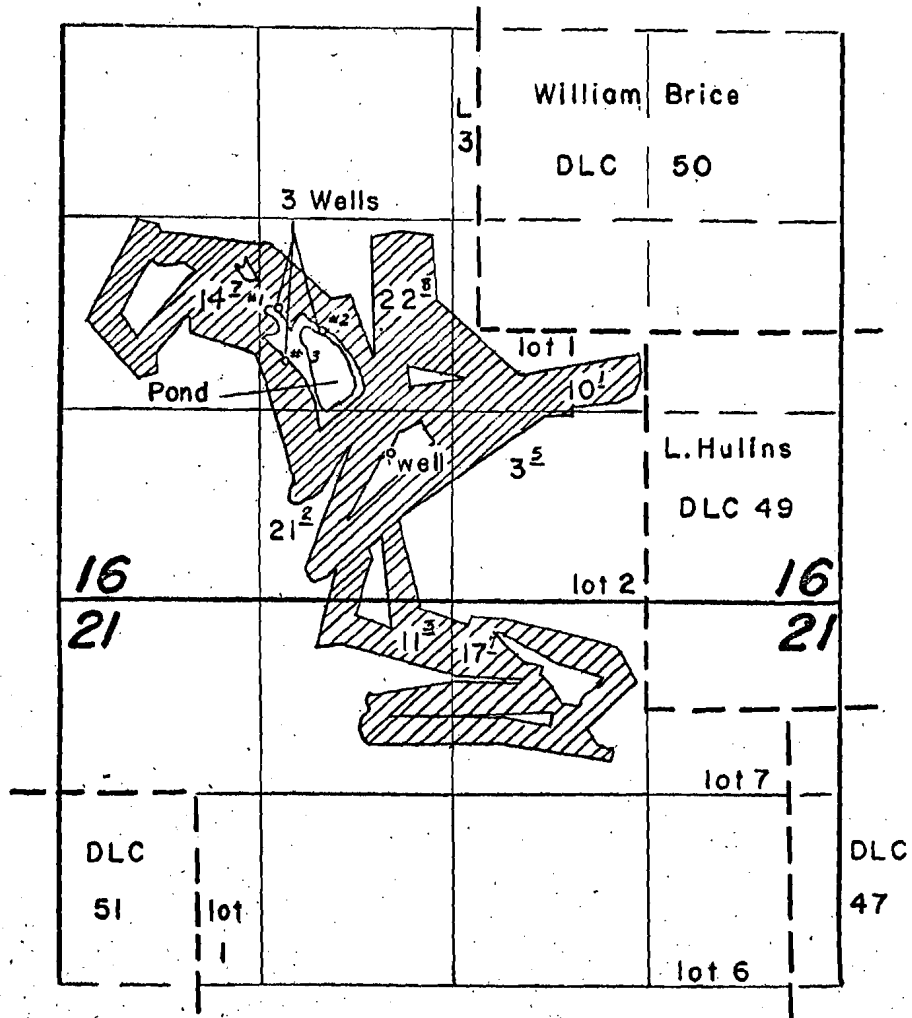

FINAL PROOF SURVEY UNDER

Application No. *G-2451* / *G-2152* Permit No. *G-2269* / *G-2031*
IN NAME OF

BOHEMIA LUMBER Co., Inc.

Surveyed *June 21, 1963*, by *T. Louer*,
Sept. 2, 1964 *F. Siegmund*