


T. 16 S. R. 4 W. W.M.

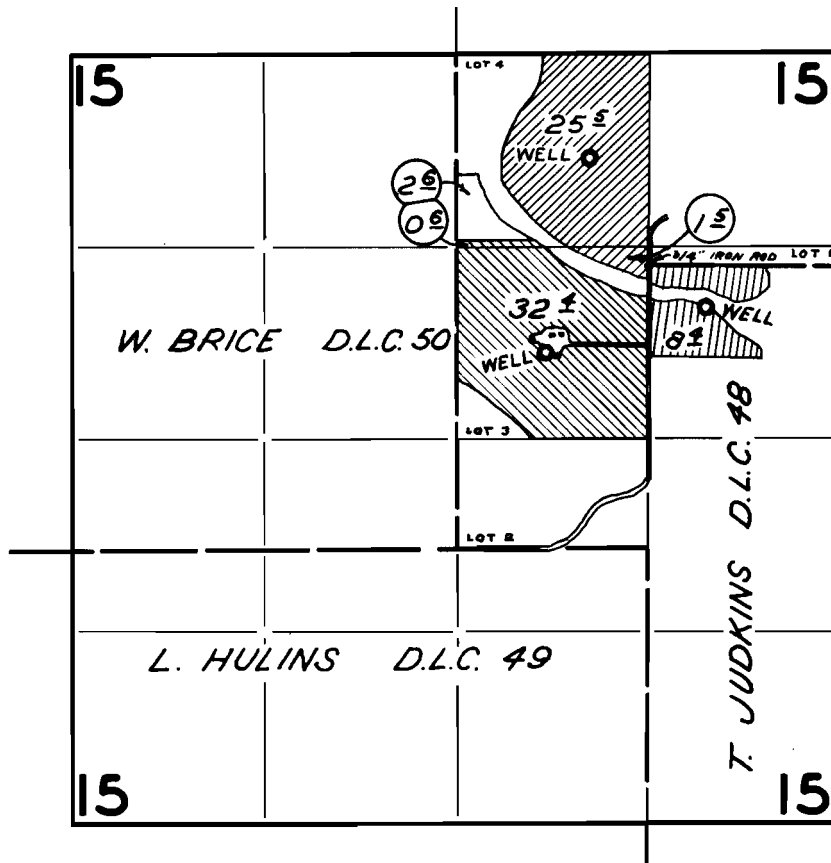

-  SOUTH WELL
-  EAST WELL
-  NORTH WELL

FINAL PROOF SURVEY UNDER

Application No. G-2638 Permit No. G-2444
IN NAME OF

JOHN T. & BESSIE JANE BRICE, JR.

Surveyed MAY 7 1964, by R. JACKSON