


T.15S. R.4W. W.M.

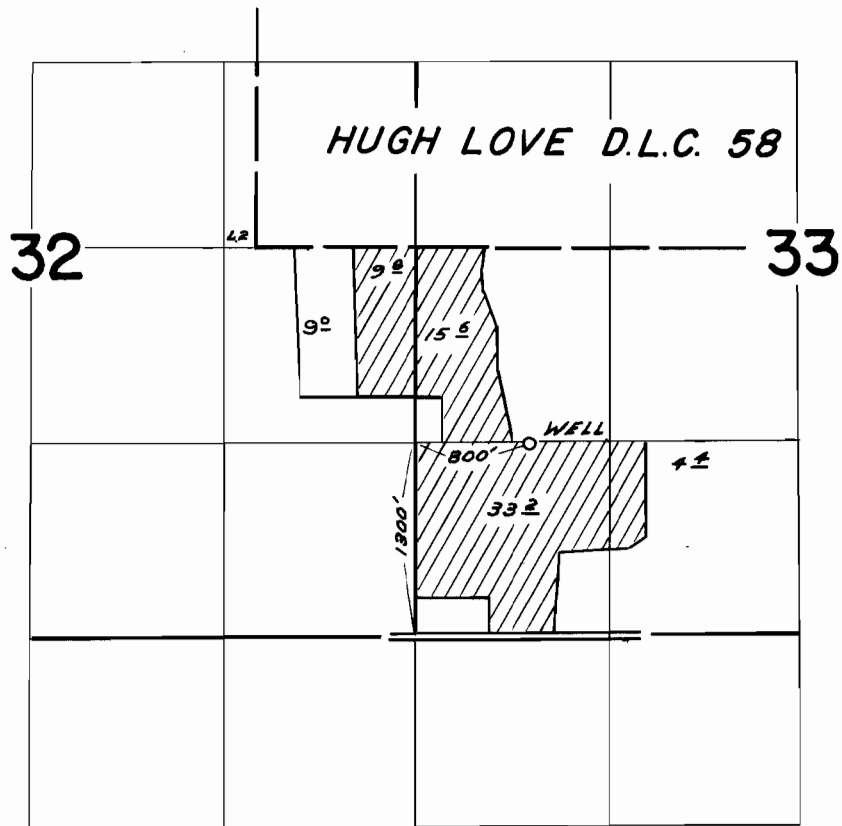

**FINAL PROOF SURVEY**  
UNDER

Application No. 6-2753 Permit No. 6-2558  
IN NAME OF

ARTHUR G. & ESTER JAGER,

Surveyed APR 28 1965, by L. COLEBANK