


T.12S.R.8W.W.M.

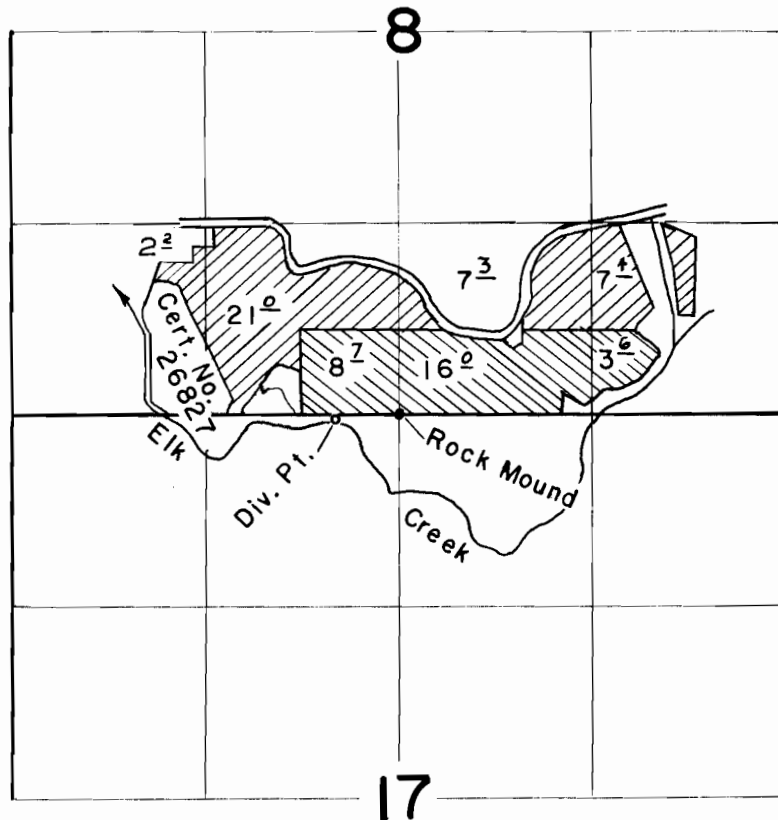

App. No. 39594

App. No. 34872

FINAL PROOF SURVEY
UNDER

39594 29425
Application No. 34872 Permit No. 27370
IN NAME OF

Don F. Kessi

Surveyed Sept. 23 1964, by F. Siegmund