


# T.11S.R.2W.W.M.

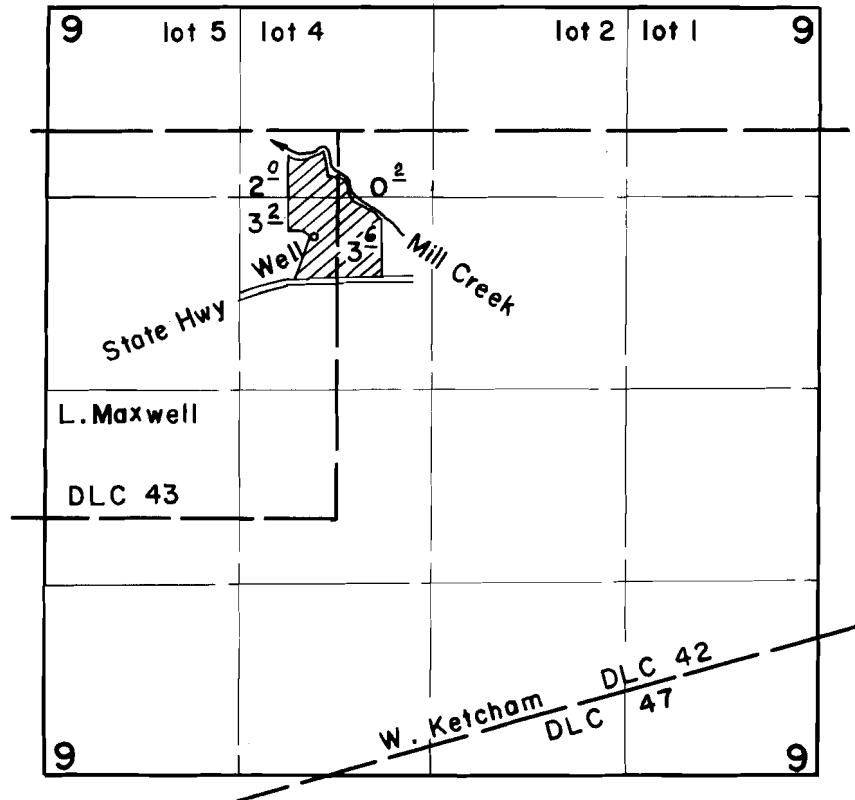

## FINAL PROOF SURVEY UNDER

Application No. G-2031 Permit No. G-1868  
IN NAME OF

*RODNEY D. OR JOANN CHRISTENSEN*

Surveyed Nov. 4, 1964, by R. Jackson