


T.10S.R.2W.W.M.

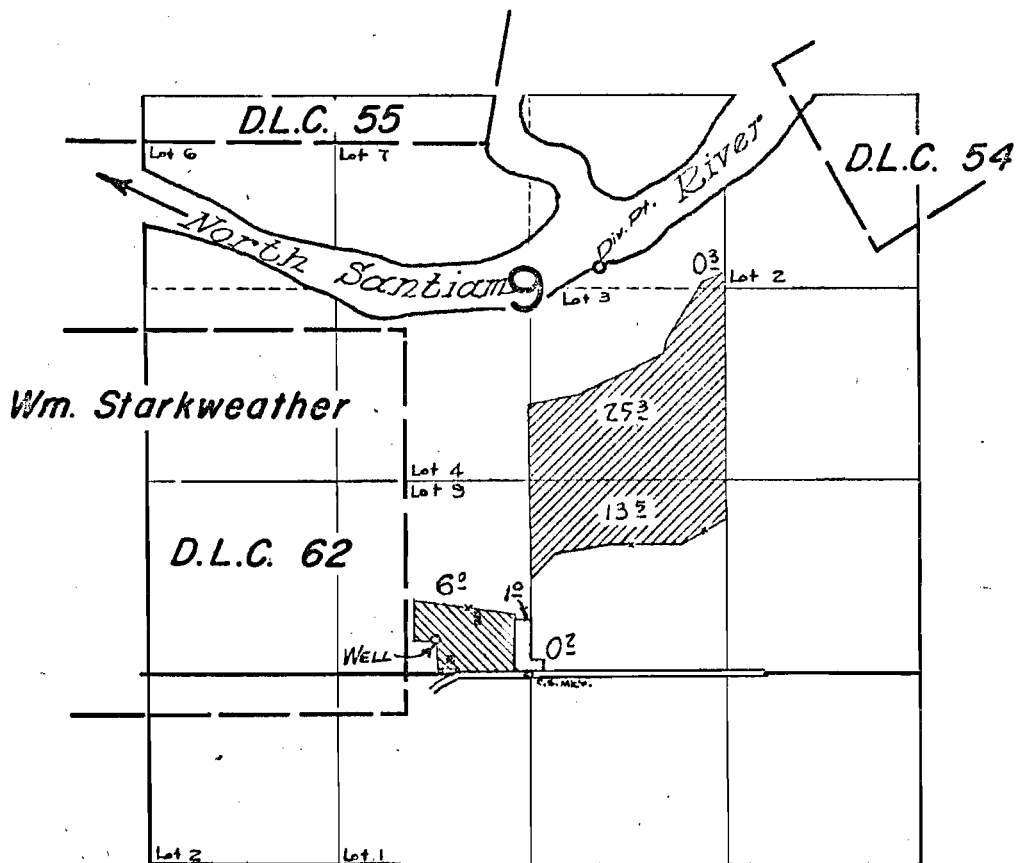

G-2224 
37378 

FINAL PROOF SURVEY UNDER

G-2224 G-2046
Application No. 37378 Permit No. 27823...
IN NAME OF

KENNETH ELLIS

Surveyed May 1, 1964, by 