


T.9 S.R.1 W.W.M.

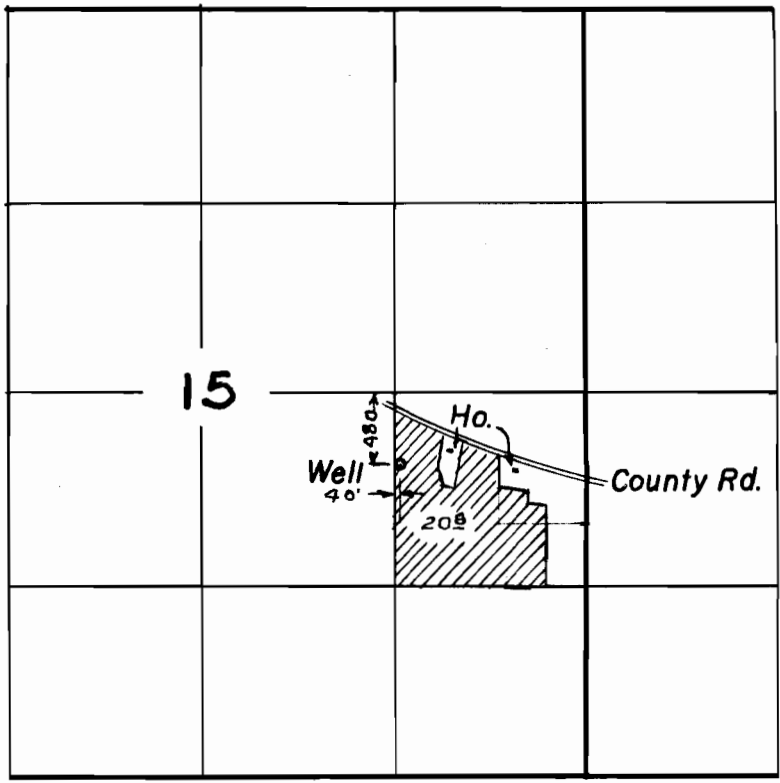

FINAL PROOF SURVEY
UNDER

Application No. *G-2361* Permit No. *G-2164*
IN NAME OF

De Witt Tiger

Surveyed *May 26 1965*, by *F. Siegmund*