


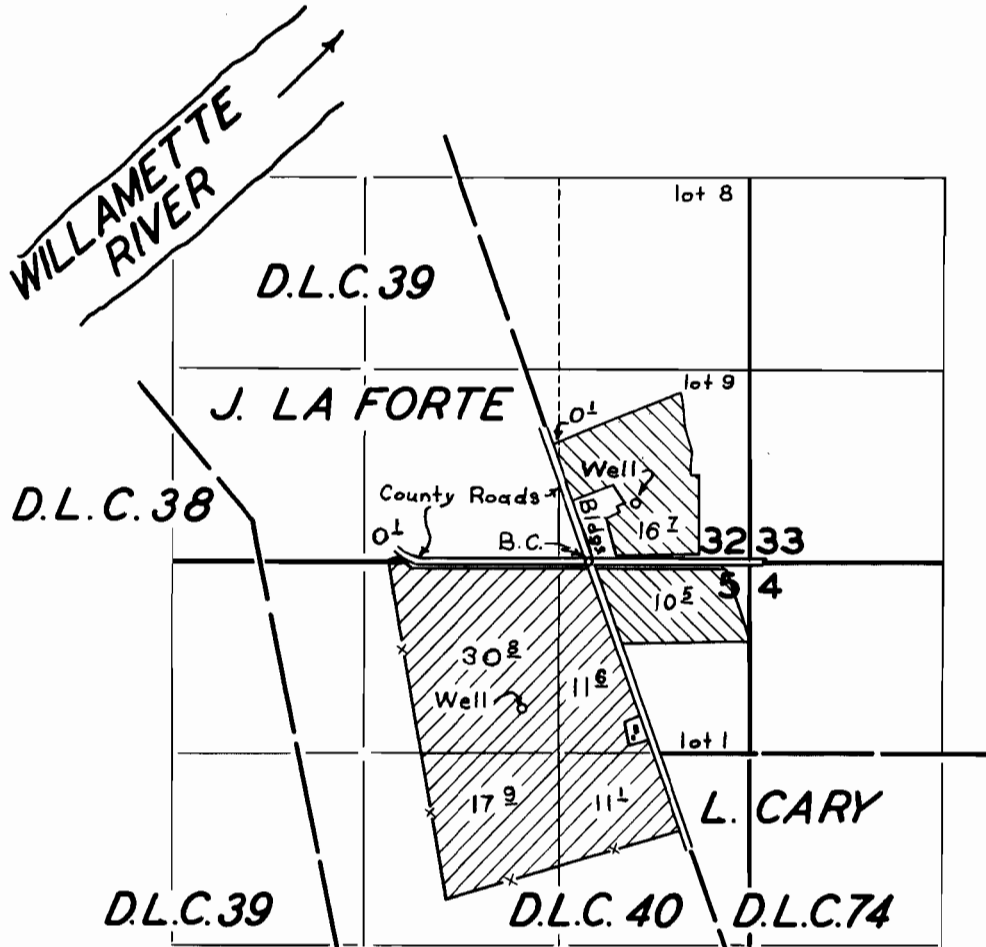

T. 3 & 4 S. R. 1 W. W. M.



-  Appl. G-1919
-  Appl. G-2683

FINAL PROOF SURVEY
UNDER

Application No. G-1919 Permit No. G-1774
G-2683 Permit No. G-2481
 IN NAME OF

SMITH & HUBBARD DAIRY

Surveyed June 25, 1964, by R. JACKSON