


T. 6 S. R. 1 E. W. M.

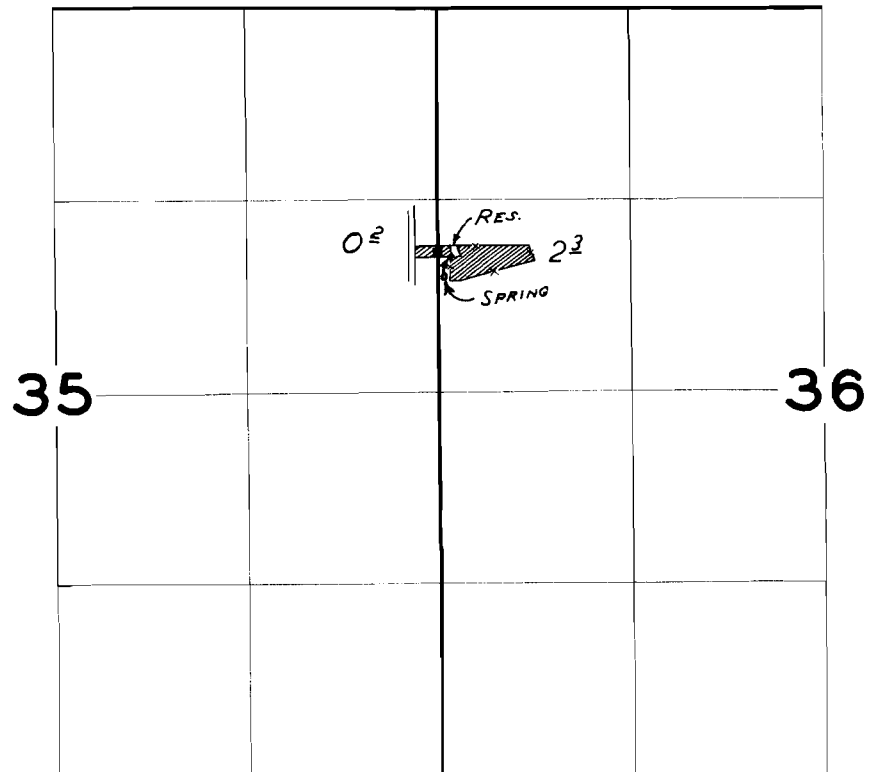

FINAL PROOF SURVEY
UNDER

Application No. R-37168
37169 Permit No. R-2700
27581
IN NAME OF

EMMETT L. DESKINES

Surveyed MAY 14 1964, by R. JACKSON