


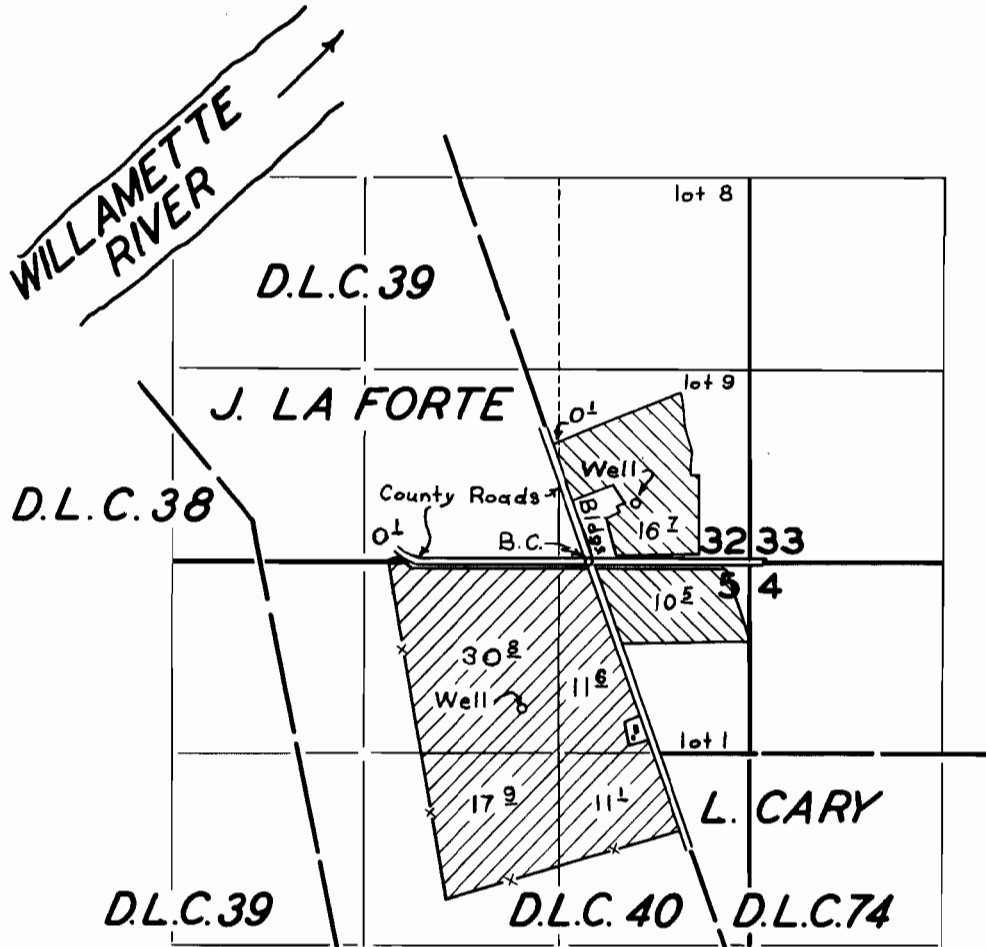

T. 3 & 4 S. R. 1 W. W. M.



-  Appl. G-1919
-  Appl. G-2683

**FINAL PROOF SURVEY**  
UNDER

Application No. G-1919 Permit No. G-1774  
G-2683 Permit No. G-2481  
 IN NAME OF

**SMITH & HUBBARD DAIRY**

Surveyed June 25, 1964, by R. JACKSON