


T. 7S. R. 1W. W.M.

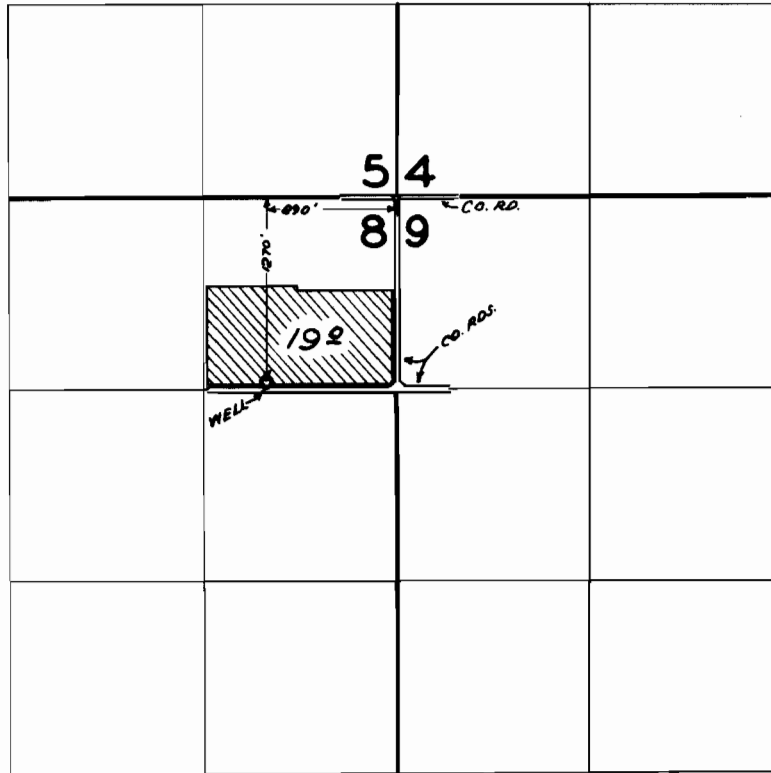

FINAL PROOF SURVEY
UNDER

Application No. G-1844 Permit No. G-1687
IN NAME OF

ALFRED KUENZI

Surveyed APR 24 1964, by F. SIEGMUND