


T.7S.R.2W.W.M.

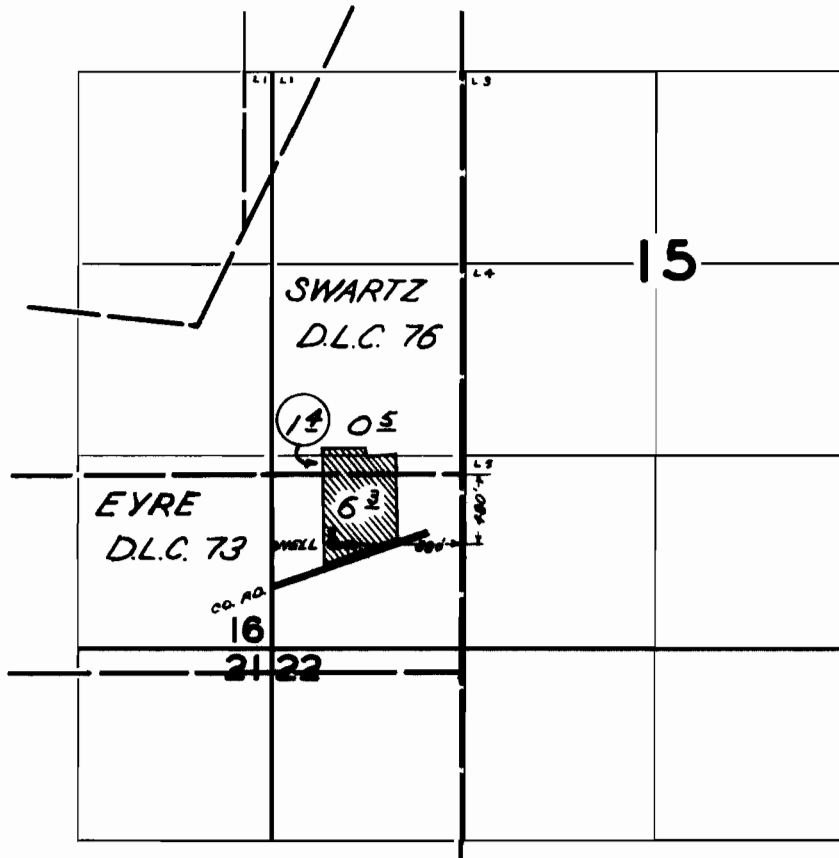

FINAL PROOF SURVEY UNDER

Application No. G-1818 Permit No. G-1662
IN NAME OF

RONALD SCHMIDT

Surveyed MAY 12 1964, by R. JACKSON