


T.7S. R.2W. W.M.

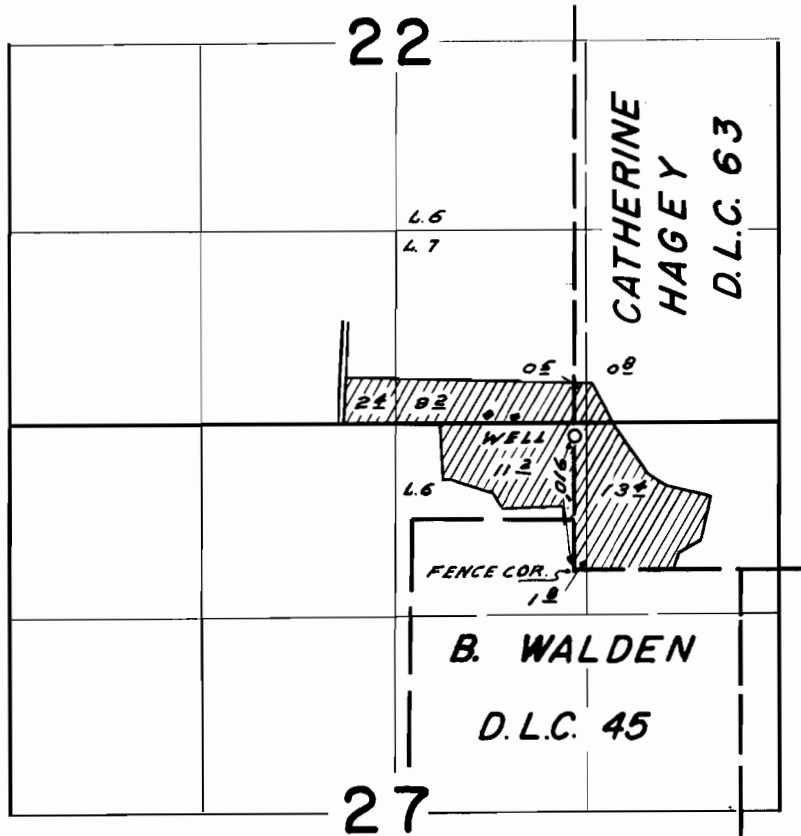

FINAL PROOF SURVEY
UNDER

Application No. G-2377 Permit No. G-2188
IN NAME OF

JOHN G. & BETTY SHAMBERGER

Surveyed APR. 16 1965, by L. COLEBANK