


T. 4 S. R. 1 W. W. M.

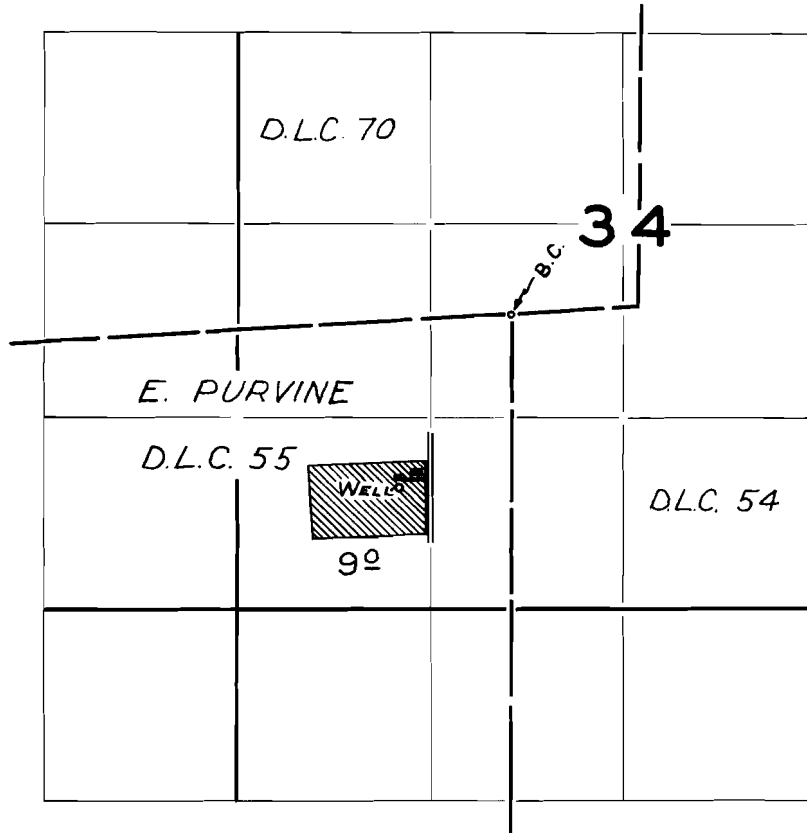

**FINAL PROOF SURVEY**  
UNDER

Application No. G-1874 Permit No. G-1717  
IN NAME OF

JOHN W. SPENCE

Surveyed JUN. 25 1964, by R. JACKSON