


T.5S.R.2 & 3 W.W.M.

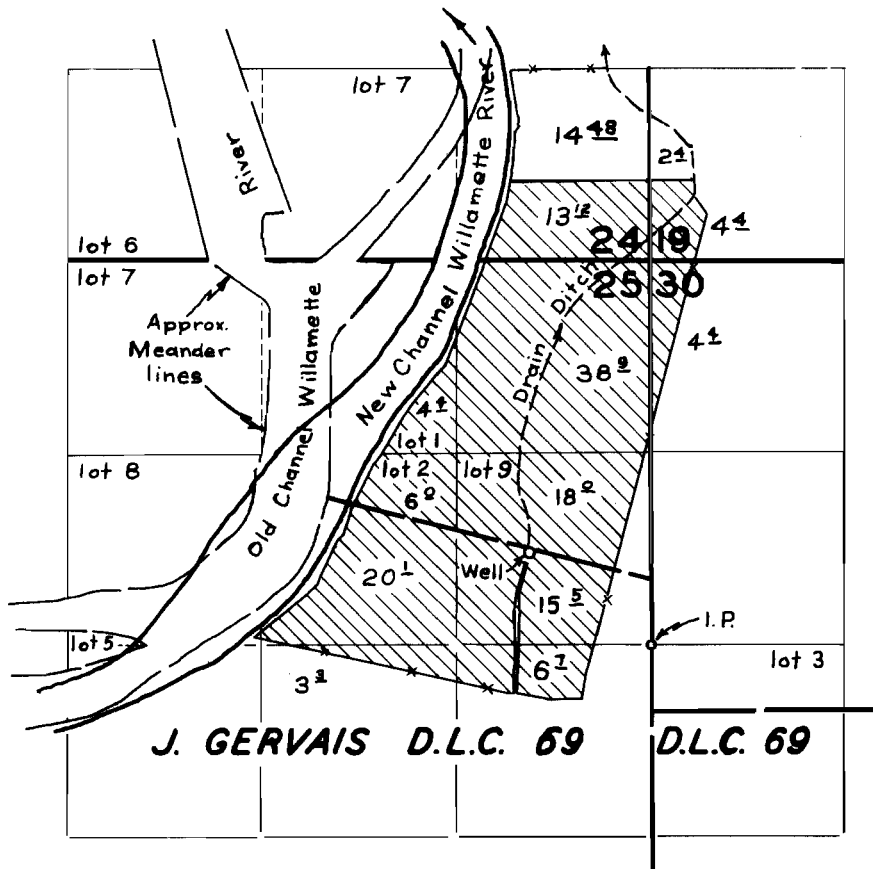

FINAL PROOF SURVEY
UNDER

Application No. G-1028 Permit No. G-882
IN NAME OF

JOHN STOCKFLETH

Surveyed June 3, 1964, by R. JACKSON