


T. 7 & 8 S. R. 5 W. W. M.

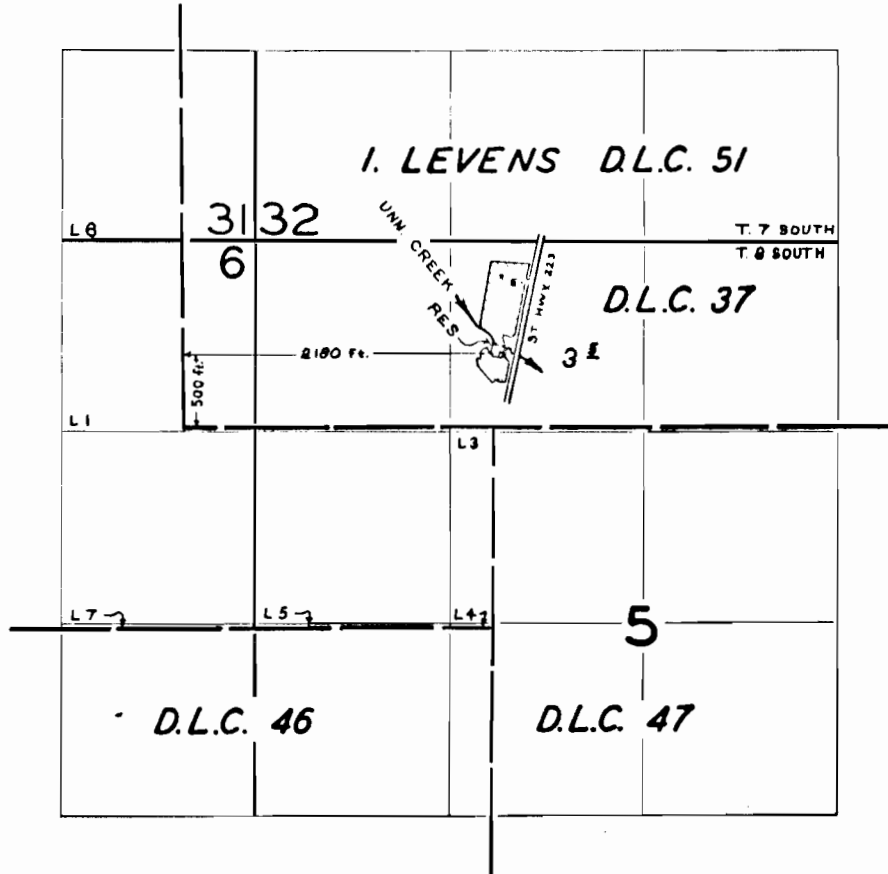

FINAL PROOF SURVEY
UNDER

Application No. ^{R-34288} 34289 Permit No. ^{R-2513} 27004
IN NAME OF

VERNE L. HUGHES

Surveyed JULY 17, 1964, by R. JACKSON