


T. 7 & 8 S. R. 5 W. W.M.

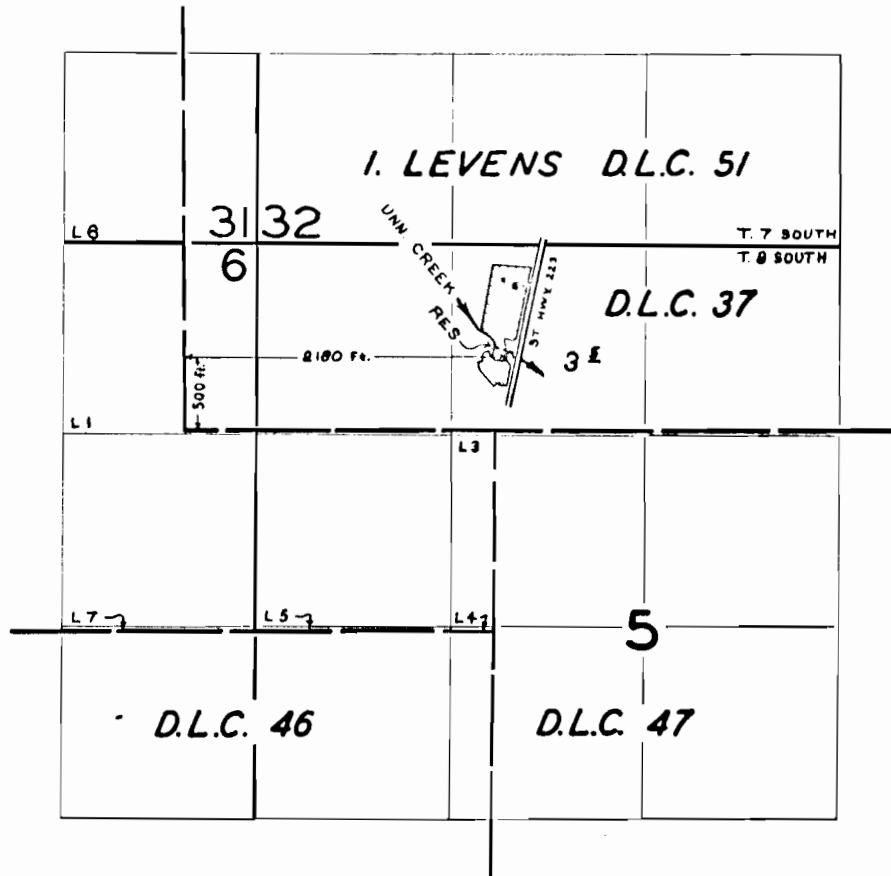

FINAL PROOF SURVEY UNDER

Application No. ^{R-34288} 34289 Permit No. ^{R-2513} 27004
IN NAME OF

VERNE L. HUGHES

Surveyed July 17, 1964, by R. JACKSON