


T.2S.R.2W.W.M.

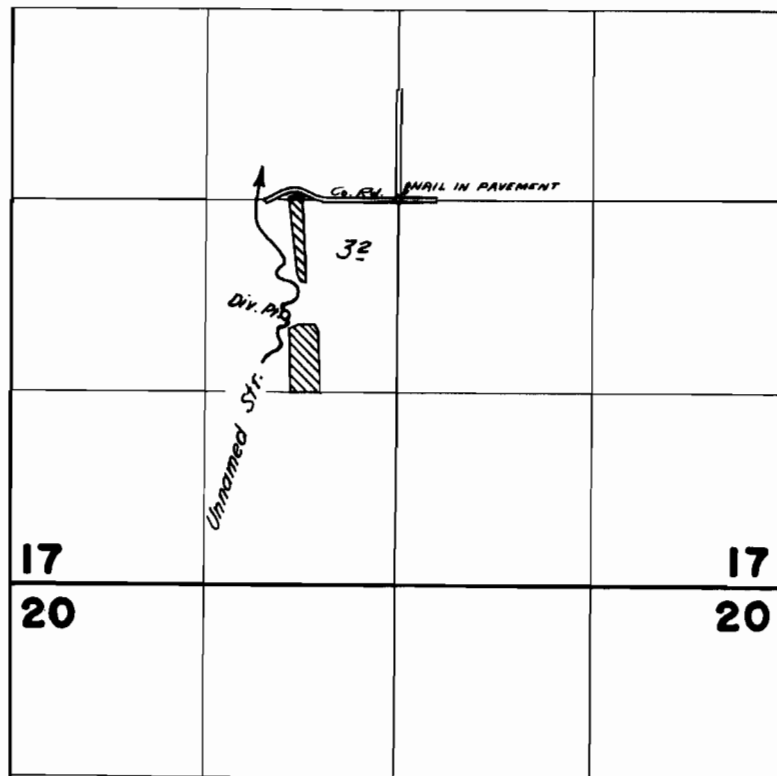

FINAL PROOF SURVEY
UNDER

Application No. **26029** Permit No. **21119**
IN NAME OF

HARRY & BANNETTA DIXON

Surveyed *August 18* 1961, by *R. H. Jackson*