


T.5S.R.7W.W.M.

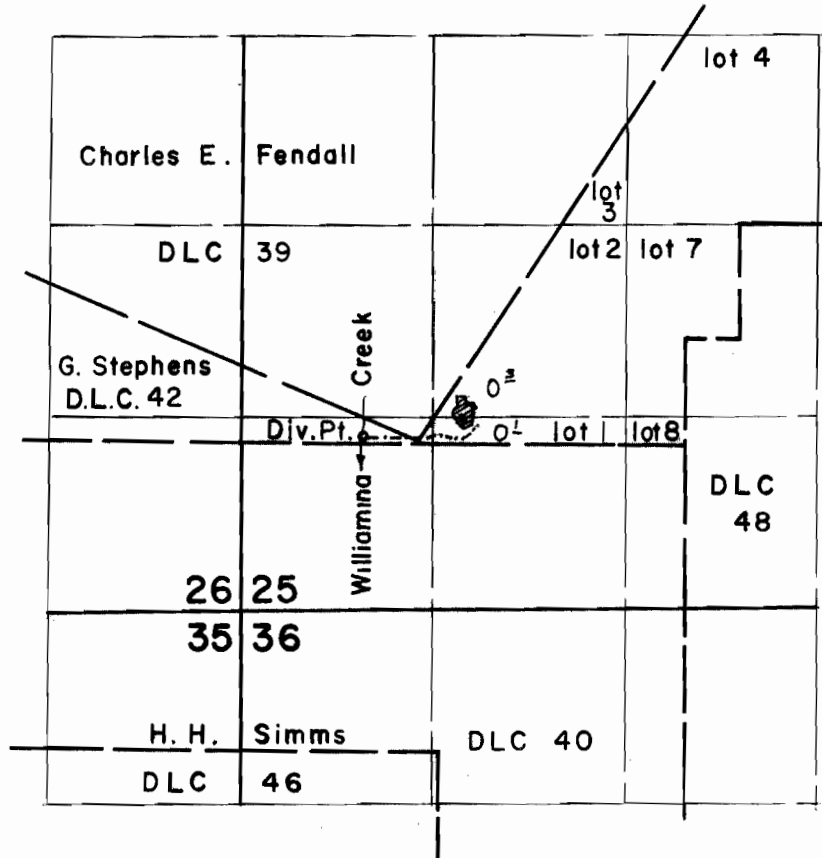

FINAL PROOF SURVEY UNDER

Application No. 33966 Permit No. 26775
IN NAME OF

Mrs. E. D. Arend

Surveyed Sept 24, 1964, by R. Jackson