


T. 3 S. R. 5 W. W.M.

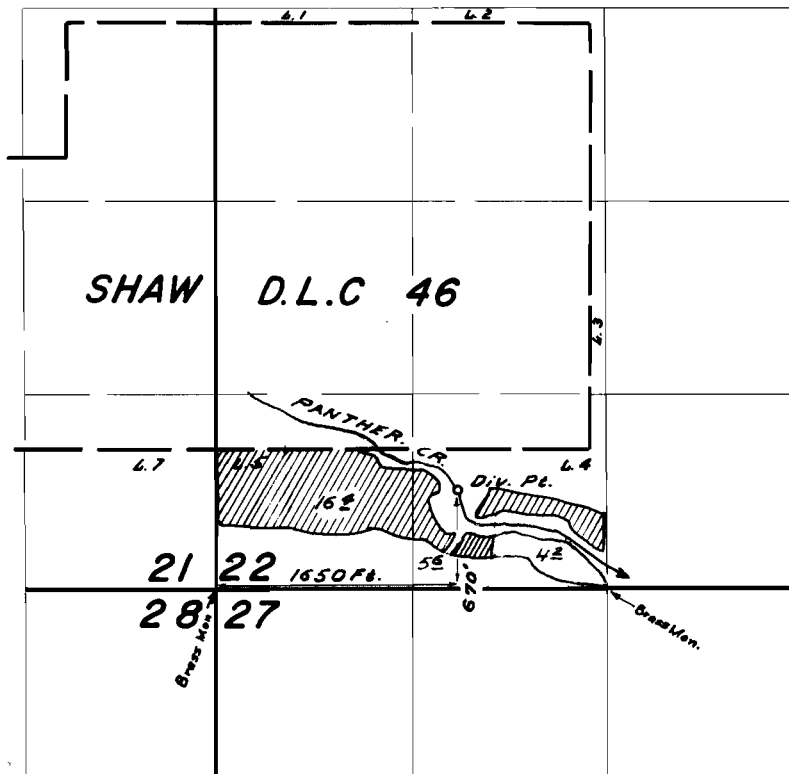

**FINAL PROOF SURVEY**  
UNDER

Application No. 34115 Permit No. 26929  
IN NAME OF

HELEN HORLYK

Surveyed AUG 2 1965 by L. COLEBANK