


# T.4&5 S.R.3W.W.M.

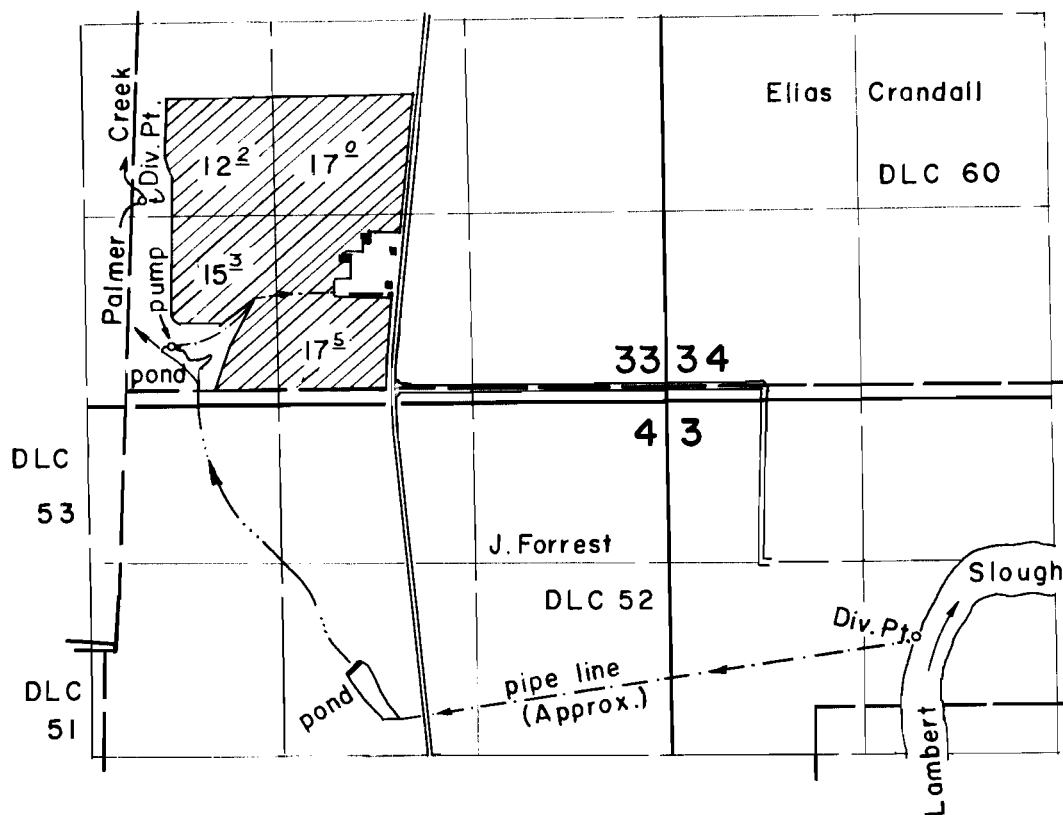

## FINAL PROOF SURVEY UNDER

34188                      26940  
 Application No. 34752    Permit No. 27282  
 IN NAME OF

Glen A. McFarlane

Surveyed Sept 23 1964, by R. Jackson