


T.4S.R.7W.W.M.

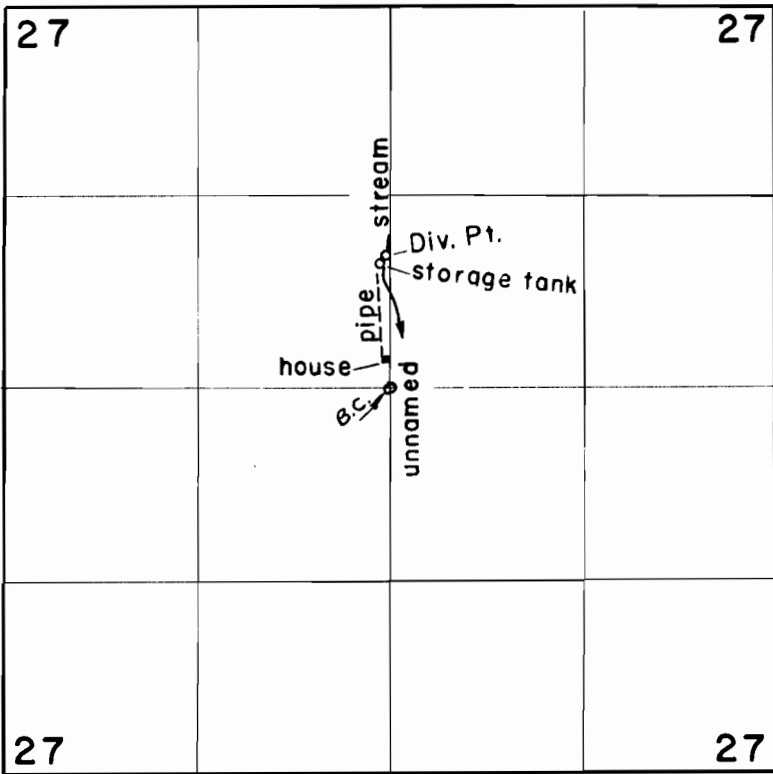

FINAL PROOF SURVEY

Application No. 34992 Permit No. 27473
IN NAME OF

Charlotte A. Rasmussen

Surveyed Aug 26, 1964, by R. Jackson