


T.3&4 S.R.2 W.W.M.

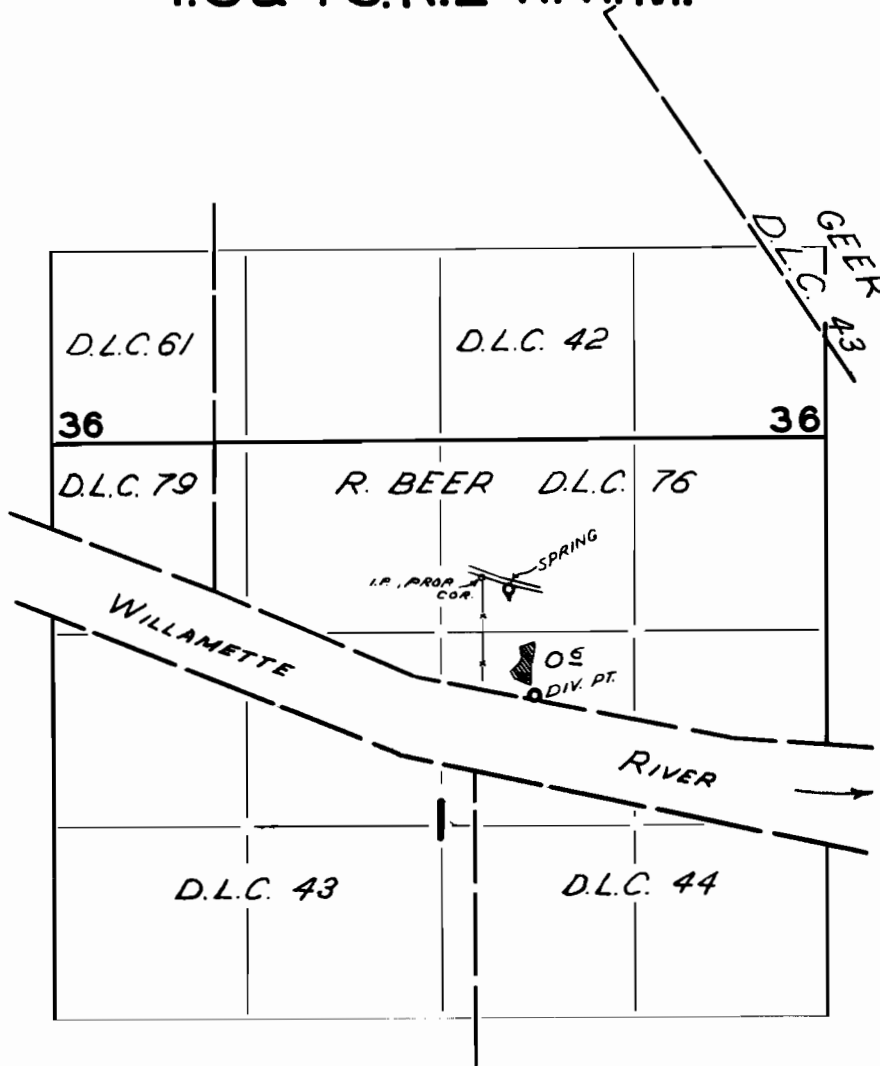

FINAL PROOF SURVEY
UNDER

Application No. 37732 Permit No. 28127
IN NAME OF

DUANE YOUNGBAR

Surveyed SEP. 22 1964, by R. JACKSON